

Harrison
5-1-69

MISSISSIPPI
 BOARD OF WATER COMMISSIONERS
 416 North State Street
 Jackson, Mississippi 39201
CODED
WATER WELL DRILLERS LOG

5-1 1969 Switzer Shell Co. Harrison
 date well completed firm name county well located

LANDOWNER: James Starks
Const. Co., Rt. 1, Box 137A
Biloxi Miss 39532
 (mailing address)

WELL LOCATION:
 sec. 7 T 7 N R 9 E
4 miles N of Biloxi
 (distance) (direction) (nearest town)

WELL PURPOSE: commercial
 (home, irrigation, municipal, industrial)

WELL COMPLETION DATA:
 (1) diameter (inches) 2 x 4
 (2) total depth (feet) 564
 (3) static water level (feet) 54 below above top of ground.
 (4) casing gal. steel 544'
 (material) (depth)
2 x 4 If telescope see back.
 (size)
 (5) screen 20' 544'
 (length) (depth to top)
8 in SS on pipe
 (size) (material)
 (6) pump 1/4 600 gph
 (HP) (yield)
electric
 (type power)
 (7) electric log No
 (yes or no)
 (organization running log)
 (8) how well bottom plugged Back
pressure valve

description of formations encountered	from to	
<u>Mixed</u>	<u>0</u>	<u>21</u>
<u>Fine sand</u>	<u>21</u>	<u>43</u>
<u>Mixed</u>	<u>43</u>	<u>146</u>
<u>Clay</u>	<u>146</u>	<u>188</u>
<u>Mixed</u>	<u>188</u>	<u>289</u>
<u>Sand</u>	<u>289</u>	<u>299</u>
<u>Fine clay</u>	<u>299</u>	<u>305</u>
<u>Clay</u>	<u>305</u>	<u>326</u>
<u>Mixed</u>	<u>326</u>	<u>366</u>
<u>Clay</u>	<u>366</u>	<u>387</u>
<u>Mixed</u>	<u>387</u>	<u>447</u>
<u>Clay</u>	<u>447</u>	<u>470</u>
<u>Fine sand</u>	<u>470</u>	<u>489</u>
<u>Good sand</u>	<u>489</u>	<u>564</u>

DRILLERS REMARKS:


SEE PAGE 2
 MISS. ED. OF
 WATER BOARD

If well telescopes please sketch and show depths.

GROUND LEVEL

105" OF 4"

439' OF 2"

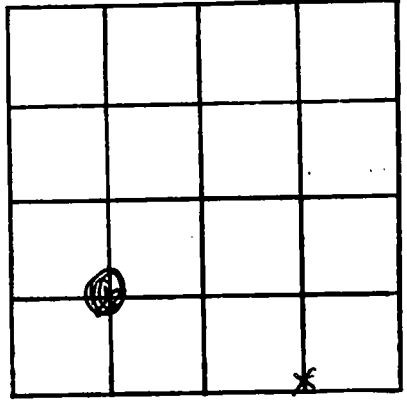

SECTION 7 (7)

Please indicate well location X.

ADDITIONAL INFORMATION

If more than one screen, show locations of each on sketch.