

Harrison
M312
5-15-69

MISSISSIPPI
BOARD OF WATER COMMISSIONERS
416 North State Street
Jackson, Mississippi 39201

CODED

WATER WELL DRILLERS LOG

5-15 1969 date well completed
Switzer Well Co. firm name
Harrison county well located

LANDOWNER: John Briggs
Cedar Lake Road
Biloxi Miss.
(mailing address)

description of formations encountered	from	to
Mixed	0	2.2
Clay	2.2	4.3
Mixed	4.3	6.3
Clay	6.3	10.3
Mixed	10.3	16.5
Fair soil	16.5	19.5

WELL LOCATION:
sec. 12 T 7 N R 10 E
S W
4 miles N of Biloxi
(distance) (direction) (nearest town)

WELL PURPOSE: Home
(home, irrigation, municipal, industrial)

WELL COMPLETION DATA:


- (1) diameter (inches) 2 x 4
- (2) total depth (feet) 19.5
- (3) static water level (feet) 38 below above top of ground.
- (4) casing gal steel 125' (material) (depth)
2 x 4 (size) If telescope see back.
- (5) screen 20' 18.5' (length) (depth to top)
8 ga. ss on pipe (size) (material)
- (6) pump not installed (HP) (yield gpm)
(type power)
- (7) electric log No (yes or no)
(organization running log)

(8) how well bottom plugged Back pressure valve

DRILLERS REMARKS:

If well telescopes please sketch and show depths.

GROUND LEVEL

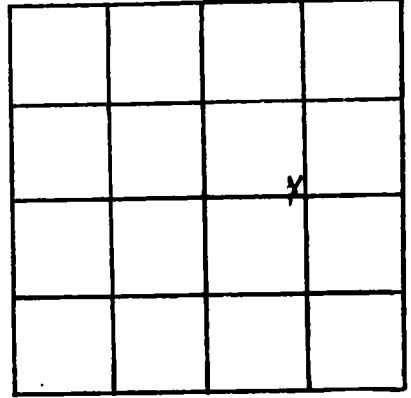

SECTION 12

Please indicate well location X.

ADDITIONAL INFORMATION

If more than one screen, show locations of each on sketch.

Horizontal lines for entering additional information.