

Harrison
 M 326
 12-27-69

MISSISSIPPI
 BOARD OF WATER COMMISSIONERS
 416 North State Street
 Jackson, Mississippi 39201

CODED

WATER WELL DRILLERS LOG

Dec. 27 1969 M&B Drilling Co. Harrison
 date well completed firm name county well located

LANDOWNER: Frank Horsthoff
 2 - East 52nd St.
 Gulfport, Miss.
 (mailing address)

WELL LOCATION:
 sec. 5 T. 7 S. R. 10 W.
 5 miles N of Miss. City
 (distance) (direction) (nearest town)

WELL PURPOSE: Camp on River
 (home, irrigation, municipal, industrial)

WELL COMPLETION DATA:
 (1) diameter (inches) 2"
 (2) total depth (feet) 270
 (3) static water level (feet) 6 below above top of ground.
 (4) casing PVC Total (material) (depth)
 2" (size) if telescope see back.
 (5) screen 9 FT. 276 (length) (depth to top)
 2" PVC Sand Pac (size) (material)
 (6) pump 1/2 10 (HP) (yield gpm)
 110V (type power)
 (7) electric log No (yes or no)

description of formations encountered	from to	
Surface Sand	0	16
Black Muck	16	22
Sand & Gravel	22	45
Light Blue Clay	45	80
Sand & Silt	80	90
Dark Grey Clay	90	120
Blue Clay	120	130
Fine Sand	130	155
Blue Clay	155	265
Sand - Grey	265	285
Blue Clay	285	290

(organization running log)


(8) how well bottom plugged
 2" PVC Cap

DRILLERS REMARKS:

JAN - 5 1970

If well telescopes please sketch and show depths.

GROUND LEVEL

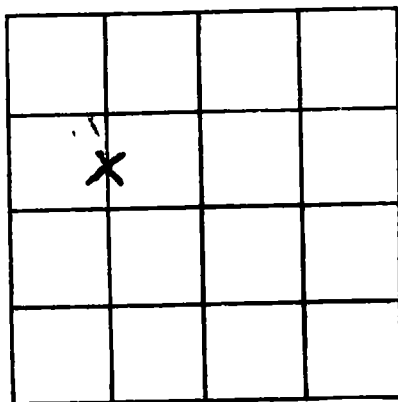

SECTION 5

Please indicate well location X.

ADDITIONAL INFORMATION

If more than one screen, show locations of each on sketch.