

Harrison
 M 330
 10-11-69

MISSISSIPPI
 BOARD OF WATER COMMISSIONERS
 416 North State Street
 Jackson, Mississippi 39201

CODED
 CODED

WATER WELL DRILLERS LOG

10/11/69 19 Coastal Drilling Harrison
 date well completed firm name county well located

LANDOWNER: Lain Smith
 1049 5th St
 Spt, Miss
 (mailing address)

description of formations encountered	from	to
	Sugar Sand	1
Coarse white sand	75	120
Blue Clay	120	250
fine water sand	250	275
Blue Clay	275	300
Coarse water sand	300	337

WELL LOCATION:
 sec. 31 T. 2 S. R. 10 E.
1 miles S of Henderson
 (distance) (direction) (nearest town)

WELL PURPOSE: Home
 (home, irrigation, municipal, industrial)

WELL COMPLETION DATA:
 (1) diameter (inches) 2"
 (2) total depth (feet) 337
 (3) static water level (feet) 27 below above top of ground.
 (4) casing galv. 337
 (material) (depth)
 (size) if telescope see back.
 (5) screen 10' 327
 (length) (depth to top)
2" SS
 (size) (material)
 (6) pump 1/2 18
 (HP) (yield gpm)
Elec
 (type power)
 (7) electric log NO
 (yes or no)

(organization running log)
 (8) how well bottom plugged BW
good


DRILLERS REMARKS:
None

JAN 12 1970

MISS. Bd. of
 WATER COMM.

If well telescopes please sketch and show depths.

GROUND LEVEL

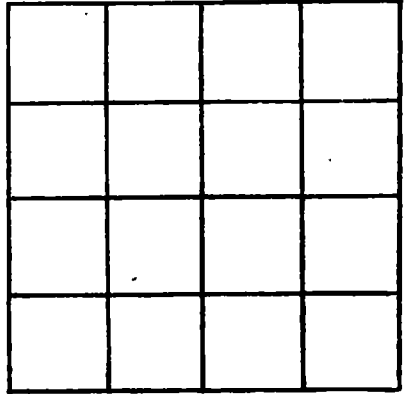

SECTION _____

Please indicate well location X.

ADDITIONAL INFORMATION

If more than one screen, show locations of each on sketch.