

Harrison
M331
10-27-69

MISSISSIPPI
BOARD OF WATER COMMISSIONERS
416 North State Street
Jackson, Mississippi 39201

CODED
CODED

WATER WELL DRILLERS LOG

10/27 1969 Coastal Drilling Harrison
date well completed firm name county well located

LANDOWNER: Mr. D. H. Read Rt 1 Box 715
Box 1, MISS
(mailing address)

description of formations encountered	from	to
	Red-white Clay	1
Coarse white Sand	20	42
Blue Clay	42	50
Coarse white Sand	50	72
Light Blue Clay	72	240
fine water Sand	240	267
Water Water Sand	267	300

WELL LOCATION:
sec. S 2 T 7 N R 10 E
W
Woolmarket
(distance) (direction) (nearest town)

WELL PURPOSE: Home
(home, irrigation, municipal, industrial)

WELL COMPLETION DATA:
(1) diameter (inches) 2"
(2) total depth (feet) 300'
(3) static water level (feet) 38 below top of ground.
(4) casing galv. 300'
(material) (depth)
(size) If telescope see back.
(5) screen 10' 290
(length) (depth to top)
2" SS
(size) (material)
(6) pump 1 1/2 21
(HP) (yield gpm)
ELC
(type power)
(7) electric log NO
(yes or no)
(organization running log)
(8) how well bottom plugged BH good


DRILLERS REMARKS:
None

JAN 12 1970

MISS. BD. OF
WATER COMM.

If well telescopes please sketch and show depths.

GROUND LEVEL

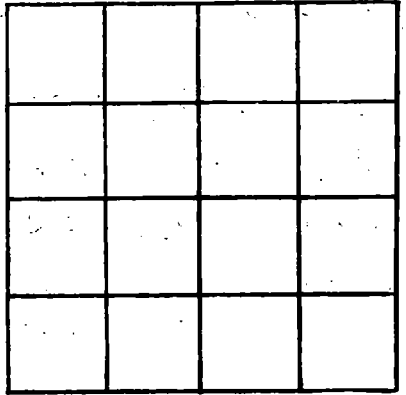

SECTION _____

Please indicate well location X.

ADDITIONAL INFORMATION

If more than one screen, show locations of each on sketch.