

Harrison
 M 333
 12-2-69

MISSISSIPPI
 BOARD OF WATER COMMISSIONERS
 416 North State Street
 Jackson, Mississippi 39201

CODED
 CODED

WATER WELL DRILLERS LOG

Switzer Well Co.

HARRISON

December 2 1969 date well completed
 firm name
 county well located

LANDOWNER: Curtis A. Fairley
 205 Boney Avenue
 Biloxi, Miss. 39531
 (mailing address)

description of formations encountered	from	to
CLAY	0	107
SAND	107	122
STREAKS	122	143
CLAY	143	408
SAND	408	418
MIXED	418	426
CLAY	426	570
STREAKS	570	591
CLAY	591	715
CLAY & SAND STREAKS	715	737
CLAY	737	774
SAND	774	864

WELL LOCATION:
 sec. 18 T 7 N R 9 E
 S W
 1 miles N of BILoxi
 (distance) (direction) (nearest town)

WELL PURPOSE:
 (home, irrigation, municipal, industrial)

WELL COMPLETION DATA:
 (1) diameter (inches) 2"
 (2) total depth (feet) 864'
 (3) static water level (feet) 16' Flow above top of ground
 (4) casing galv. 864' (material) (depth)
 (size) If telescope see back.
 (5) screen 20' 844' (length) (depth to top)
 .00855 stainless steel (size) (material) wrapped
 (6) pump 1/2 7 1/2 10 (HP) (yield gpm)
 Electric (type power)
 (7) electric log No (yes or no)
 (organization running log)
 (8) how well bottom plugged back PRESSURE VALVE


JAN 27 1970

MISS. Bd. of WATER COMMISSIONERS

DRILLERS REMARKS:

If well telescopes please sketch and show depths.

GROUND LEVEL

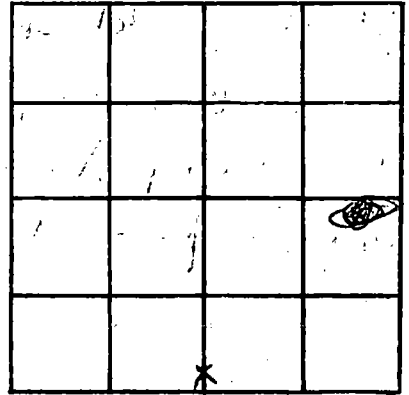

SECTION 26

Please indicate well location X.

ADDITIONAL INFORMATION

If more than one screen,
show locations of each on sketch.