

Harrison
M 337
3-1-70

MISSISSIPPI
BOARD OF WATER COMMISSIONERS
416 North State Street
Jackson, Mississippi 39201

CODED

WATER WELL DRILLERS LOG

3/1 1970 Central Mills Co. Harrison
date well completed firm name county well located

LANDOWNER: Jimmie Thompson
At 1 Bilopi, Miss
(mailing address)

description of formations encountered	from	to
White Sand	1	22
glau	22	30
White Sand	30	39
Shell	39	43
White Sand	43	72
Red Clay	72	84
Soft Blue Clay	84	176
hard Blue Clay	176	327
fine water sand	327	356
Coarse water sand	356	394

WELL LOCATION:
sec 9-T-1 R-10
2 1/2 miles S of Coburn
(distance) (direction) (nearest town)

WELL PURPOSE: Home
(home, irrigation, municipal, industrial)

WELL COMPLETION DATA:
(1) diameter (Inches) 4x2
(2) total depth (feet) 394
(3) static water level (feet) 28 below top of ground
(4) casing glau (material) 399 (depth)
4x2 (size) If telescope see back.
(5) screen 15' (length) 379 (depth to top)
2" (size) SS (material)
(6) pump 3/4 (HP) 28 (yield gpm)
Elec (type power)
(7) electric log no (yes or no)
no (organization running log)

(8) how well bottom plugged
2" baby mesh holes

DRILLERS REMARKS:
None
3/4 HP Sub pump

CODED

APR - 1 1970

MISS. BD. OF
WATER COMM.

If well telescopes please sketch and show depths.


GROUND LEVEL

147' 4" Casing

232' 2" Casing

15' S.S. Screen

1/2" 2" block Wash Valve

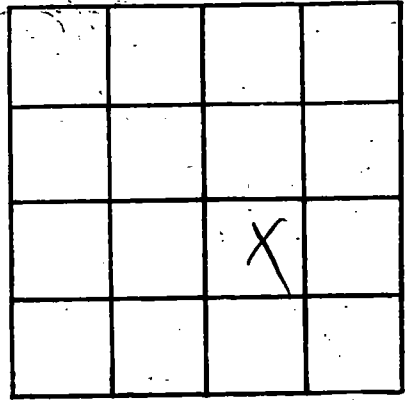

SECTION 9

Please indicate well location X.

ADDITIONAL INFORMATION

If more than one screen, show locations of each on sketch.