

Harrison  
M 338  
3-4-70

MISSISSIPPI  
BOARD OF WATER COMMISSIONERS  
416 North State Street  
Jackson, Mississippi 39201

COPIED

WATER WELL DRILLERS LOG

3/4/70 Date well completed  
Postal Wells Co. firm name  
Harrison county well located


LANDOWNER	description of formations encountered	from to	
		feet	feet
Loggins Shop Rt 2 Box 350	Top Soil	1	5
Belmont, Min (mailing address)	White Sand	5	15
	glau	15	37
	hard Blue clay	37	207
	Coarse water sand	207	223
	hard Blue clay	223	268
	fine water sand	268	300
	Coarse water sand	300	345
<b>WELL LOCATION:</b> sec. 9 T. 2 N. R. 9 E. 1/4 mile N of Okemulgee (distance) (direction) (nearest town)			
<b>WELL PURPOSE:</b> Home + Shop (home, irrigation, municipal, industrial)			
<b>WELL COMPLETION DATA:</b>			
(1) diameter (inches) 2"			
(2) total depth (feet) 345'			
(3) static water level (feet) 13 below top of ground			
(4) casing glau (material), 335 (depth)			
7/8" (size) If telescope see back.			
(5) screen 20 (length), 325 (depth to top)			
2" (size), 58 (material)			
(6) pump 1 HP (HP), 19 (yield gpm)			
9 ft (type power)			
(7) electric log no (yes or no)			
no (organization running log)			
(8) how well bottom plugged			
2" backwash valve			
<b>DRILLERS REMARKS:</b> none			

APR - 1 1970

MISS. BD. OF WATER COMMISSIONERS

If well telescopes please  
sketch and show depths.

**GROUND LEVEL**

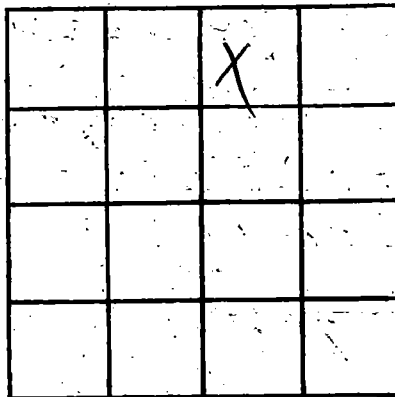

**SECTION** 9

**Please indicate well location 'X'.**

**ADDITIONAL INFORMATION**

If more than one screen,  
show locations of each on sketch.