

Harrison
 M 339
 2-10-70

MISSISSIPPI
 BOARD OF WATER COMMISSIONERS
 416 North State Street
 Jackson, Mississippi 39201
 WATER WELL DRILLERS LOG

CODED

2-10 1970 C.T. Switzer Well Co. HARRISON
 date well completed firm name county well located

LANDOWNER: Gus Casplich
Box 694 MS 67
Biloxi, Miss. 39531
 (mailing address)

WELL LOCATION:
 sec 6 T 7 S R 9 E
4 miles NW of Biloxi
 (distance) (direction) (nearest town)

WELL PURPOSE:
 (home, irrigation, municipal, industrial)

WELL COMPLETION DATA:
 (1) diameter (inches) 2"
 (2) total depth (feet) 401'
 (3) static water level (feet) 22 below top of ground.
 (4) casing GALV. 401'
 (material) (depth)
 if telescope see back.
 (size)
 (5) screen 10' 391'
 (length) (depth to top)
008 stainless steel
 (size) (material)
 (6) pump 1/2 0
 (HP) (yield gpm)
ELEC.
 (type power)
 (7) electric log NO
 (yes or no)

 (organization running log)
 (8) how well bottom plugged back
pressure valve

| description of formations encountered | depth | |
|---------------------------------------|-------|-----|
| | from | to |
| Clay | 0 | 21 |
| sand | 21 | 52 |
| Clay | 52 | 95 |
| sand | 95 | 118 |
| Clay | 118 | 194 |
| sand | 194 | 202 |
| Clay | 202 | 282 |
| sand fine | 282 | 310 |
| Clay | 310 | 382 |
| sand | 382 | 385 |
| sand - Good | 385 | 409 |

CODED


MAR 17 1970

MISS. BD. OF
 WATER COMM.

DRILLERS REMARKS:

If well telescopes please sketch and show depths.

GROUND LEVEL

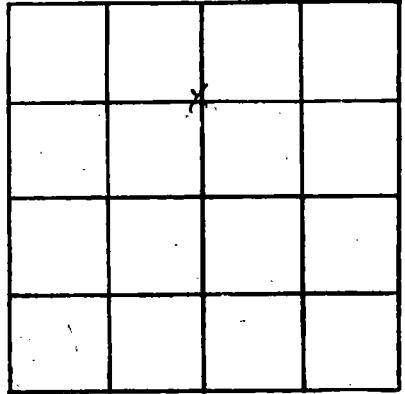

SECTION 6

Please indicate well location X.

ADDITIONAL INFORMATION

If more than one screen, show locations of each on sketch.