

HARRISON
M 340
6-13-72

MISSISSIPPI
 BOARD OF WATER COMMISSIONERS
 416 North State Street
 Jackson, Mississippi 39201

CODED

WATER WELL DRILLERS LOG

6-13 1972 Switzer Well Company Harrison
 date well completed firm name county well located

LANDOWNER: L.J. Patterson
800 E. Division
Biloxi, Miss. 39531
 (mailing address)

WELL LOCATION:
 sec. 7 T. 7 S. R. 9 W.
4 miles North of Biloxi
 (distance) (direction) (nearest town)

description of formations encountered	from	to
Clay	1	35
sand	35	39
Clay	39	79
Clay mixed	79	119
Clay	119	217
Sands	217	229
Clay	229	327
sand	327	373
Clay	373	474
sand	474	544
Clay	544	725
Sand, good	725	785

WELL PURPOSE: None
 (home, Irrigation, municipal, Industrial)

- WELL COMPLETION DATA:
- diameter (Inches) 2"
 - total depth (feet) 786'
 - static water level (feet) -17' below above top of ground
 - casing galv. 786'
 (material) (depth)
4"
 (size) If telescope see back.
 - screen 40' 736'
 (length) (depth to top)
608 Stainless steel
 (size) (material)
 - pump 1 1/2 23.2
 (HP) (yield gpm)
Electric
 (type power)
 - electric log -
 (yes or no)

CODED



(organization running log)

(8) how well bottom plugged back
pressure valve

DRILLERS REMARKS:

Handwritten notes:
 2001 2002 2003
 2004 2005 2006
 2007 2008 2009
 2010 2011 2012

If well telescopes please sketch and show depths.

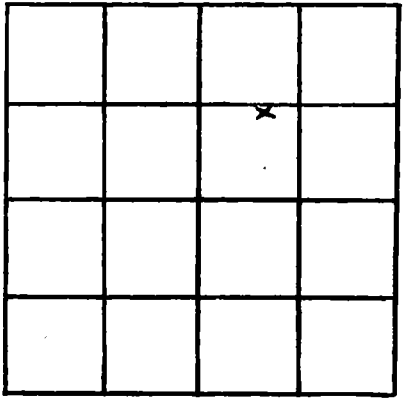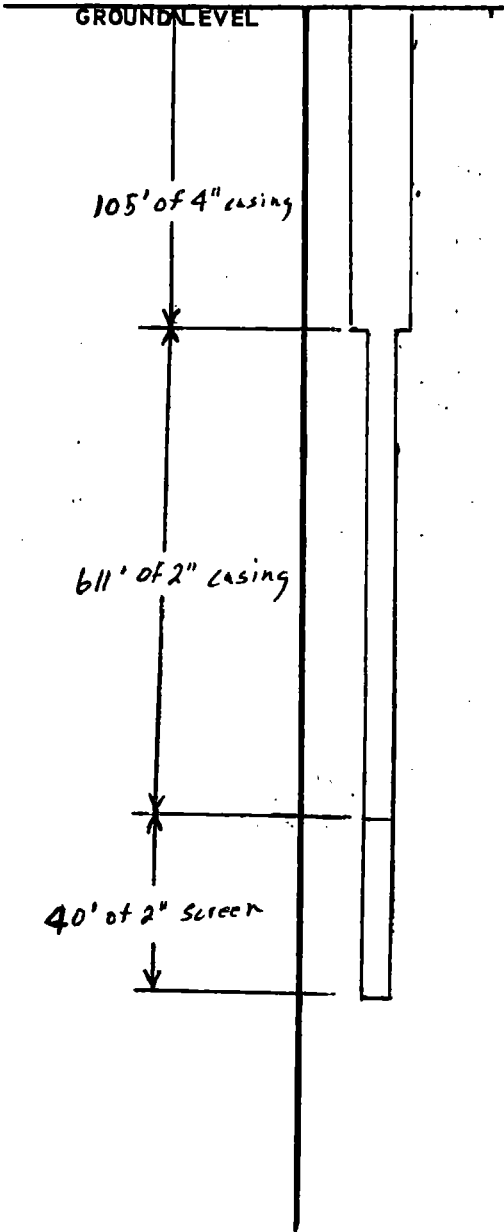

SECTION 7

Please indicate well location X.

ADDITIONAL INFORMATION

40' of 2" screen

If more than one screen,
show locations of each on sketch.