

Harrison
 M 341
 2-11-70

MISSISSIPPI
 BOARD OF WATER COMMISSIONERS
 416 North State Street
 Jackson, Mississippi 39201

WATER WELL DRILLERS LOG

CODED

2-11 date well completed 1970 Parnell Andersen firm name Jackson county well located

LANDOWNER: C.F. Gieger
 PERKINSTON MISS
 (mailing address)

description of formations encountered	from	to
Topsoil & clay	0	12
Sand	12	75
Blue Clay	75	200
Fine Sand	200	218
Blue Clay	218	256
Fine Sand	256	260
Blue Clay	260	350
Fine Sand	350	360
Coarse Sand	360	370

WELL LOCATION:
 sec. 8 T. 7 S. R. 10 E.
 4 miles S of Woolmink
 (distance) (direction) (nearest town)

WELL PURPOSE: HOME
 (home, irrigation, municipal, industrial)

- WELL COMPLETION DATA:
- (1) diameter (inches) 2
 - (2) total depth (feet) 370
 - (3) static water level (feet) 30 below top of ground
 - (4) casing Plastic, 265
 (material) (depth)
 - (size) if telescope see back.
 - (5) screen 5', 265
 (length) (depth to top)
 - 2"
 (size) (material)
 - (6) pump 3/4 (HP) 12 (yield gpm)
 - Elect
 (type power)
 - (7) electric log _____
 (yes or no)
 - _____
 (organization running log)
 - (8) how well bottom plugged _____

CODED


MAR 6 - 1970

MISS. BD. OF
 WATER COMM.

DRILLERS REMARKS:

If well telescopes please sketch and show depths.

GROUND LEVEL

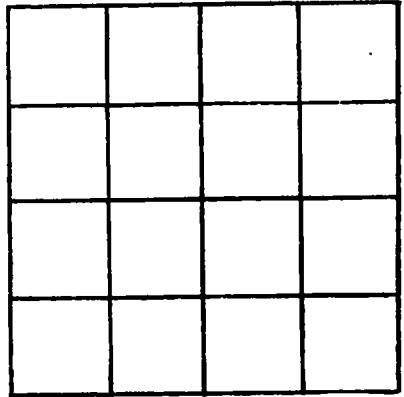

SECTION _____

Please indicate well location X.

ADDITIONAL INFORMATION

If more than one screen, show locations of each on sketch.