

Harrison
M 342
2-11-70

MISSISSIPPI
BOARD OF WATER COMMISSIONERS
416 North State Street
Jackson, Mississippi 39201

WATER WELL DRILLERS LOG

CODED
ON

2-11 1970 Perwell Anderson
date well completed firm name county well located

LANDOWNER: C.F. Gieger
Perkinstan Miss
(mailing address)

description of formations encountered	from	to
Top Soil	0	8
Red Clay	8	20
Blue Clay	20	60
Sand	60	75
Blue Clay	75	210
Fine Sand	210	230
Blue Clay	230	475
Fine Sand	475	485
Coarse Sand	485	497

WELL LOCATION:
sec. 7 T. 7 R. 10
5 miles E of Orange Grove
(distance) (direction) (nearest town)

WELL PURPOSE: Home
(home, irrigation, municipal, industrial)

- WELL COMPLETION DATA:
- (1) diameter (inches) 2
 - (2) total depth (feet) 497
 - (3) static water level (feet) 20 below top of ground
 - (4) casing Plastic, 487 (material) (depth)
 - (5) screen 10' 487 (length) (depth to top)
3" Plastic (size) (material)
 - (6) pump 1 12 (HP) (yield gpm)
Elect (type power)
 - (7) electric log (yes or no)
 - (8) how well bottom plugged

CODED


MAR 6 - 1970

MISS. BD. OF
WATER COMMISSIONERS

DRILLERS REMARKS:

If well telescopes please sketch and show depths.

GROUND LEVEL

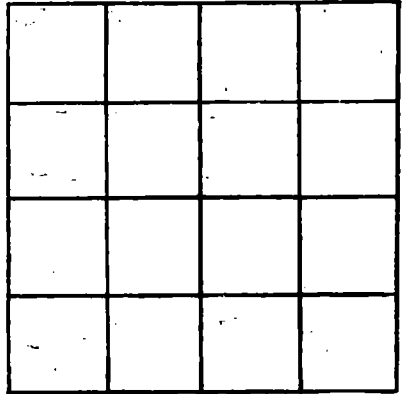

SECTION _____

Please indicate well location X.

ADDITIONAL INFORMATION

If more than one screen, show locations of each on sketch.