

Harrison
M344
2-13-70

MISSISSIPPI
BOARD OF WATER COMMISSIONERS
416 North State Street
Jackson, Mississippi 39201

WATER WELL DRILLERS LOG

CODED

2/13/70 19 COASTAL DRILLING CO HARRISON
date well completed firm name county well located

LANDOWNER: WOLF MANUEL
Pt #2 Box 640
Biloxi Miss
(mailing address)

description of formations encountered	from	to
Top Soil	1	3
White Sand	3	7
Blue Clay	7	27
gray white Sand	27	64
blue Clay	64	274
fine water Sand	274	292
Hard Blue Clay	292	325
fine water Sand	325	347
Coarse Water Sand	347	368

WELL LOCATION:
sec. 18 T 2 N R 9 E
S W
1 1/2 miles NW of Biloxi
(distance) (direction) (nearest town)

WELL PURPOSE: home
(home, irrigation, municipal, industrial)

WELL COMPLETION DATA:

(1) diameter (inches) 2"

(2) total depth (feet) 368'

(3) static water level (feet) 17' below top of ground

(4) casing galv. 358'
(material) (depth)
no (size) if telescope see back.

(5) screen 10' 358'
(length) (depth to top)
2" 58'
(size) (material)

(6) pump 1 HP 18
(HP) (yield gpm)
ELe
(type power)

(7) electric log no
(yes or no)

(organization running log)

CODED

(8) how well bottom plugged
2" leaded shot


DRILLERS REMARKS:
good well

MAR 12 1970

MISS. BD. OF
WATER COMMISSIONERS

If well telescopes please sketch and show depths.

GROUND LEVEL

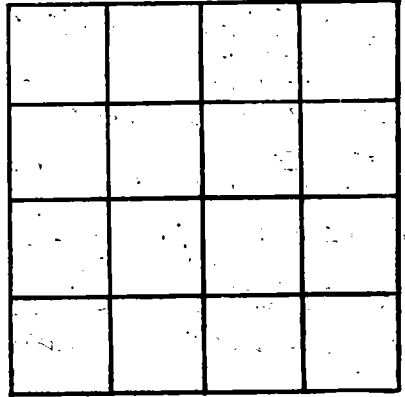

SECTION _____

Please indicate well location X.

ADDITIONAL INFORMATION

If more than one screen, show locations of each on sketch.