

Harrison
 M 348
 2-23-70

MISSISSIPPI
 BOARD OF WATER COMMISSIONERS
 416 North State Street
 Jackson, Mississippi 39201

CODED

WATER WELL DRILLERS LOG

2-23 1970 R. J. Moore HARRISON
 date well completed firm name county well located

LANDOWNER: Mrs. Basil Smith
 Day Road N. Biloxi
 Biloxi Miss.
 (mailing address)

description of formations encountered	from	to
TOP SAND & CLAY	0.	45
WHITE SAND	45	61
BLUE CLAY	61	250
FINE SAND	250	254
BLUE CLAY	254	377
GREY SAND	377	389

WELL LOCATION:
 sec. 8 T. 7 N. R. 9 E.
 IN NORTH BILOXI
 (distance) miles (direction) of (nearest town)

WELL PURPOSE:
 (home, irrigation, municipal, industrial)

WELL COMPLETION DATA:

(1) diameter (inches) 2"

(2) total depth (feet) 389

(3) static water level (feet) 55 (below) above top of ground.

(4) casing GALV. 379.
 (material) (depth)

(size) If telescope see back.

(5) screen 2 X 10. 379
 (length) (depth to top)

2" 55
 (size) (material)

(6) pump 1HP 640(HQ)
 (HP) (yield gpm)

FLEC
 (type power)

(7) electric log _____
 (yes or no)

(organization running log)

(8) how well bottom plugged BW
 VALVE

CODED

MAR 16 1970

MISS. BD. OF WATER COMM.


MAR 1

MISS. BD. OF WATER COMM.

DRILLERS REMARKS:

If well telescopes please sketch and show depths.

GROUND LEVEL

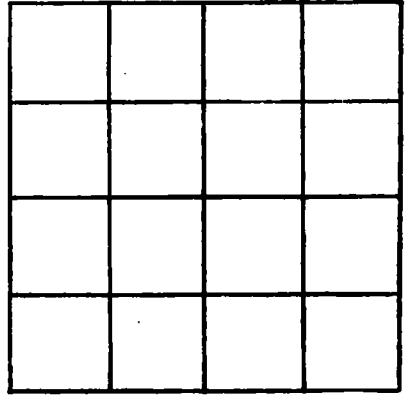

SECTION _____

Please indicate well location X.

ADDITIONAL INFORMATION

If more than one screen, show locations of each on sketch.