

Harrison
M349
2-25-70

MISSISSIPPI
BOARD OF WATER COMMISSIONERS
416 North State Street
Jackson, Mississippi 39201

CODED

WATER WELL DRILLERS LOG

Feb. 25 1970 M&B Drilling Co. Harrison
date well completed firm name county well located

LANDOWNER:
Colonial Co. Rager

WELL LOCATION:
sec. 32 T 7 S R 10 E
1.4 miles Miss. of City
(distance) (direction) (nearest town)

WELL PURPOSE: Motel
(home, irrigation, municipal, industrial)

WELL COMPLETION DATA:

(1) diameter (inches) 4" x 3"

(2) total depth (feet) 660

(3) static water level (feet) 20 below top of ground.

(4) casing Galvanized Steel - Total
(material) (depth)
4" x 3" if telescope see back.
(size)

(5) screen 20 FT, 640
(length) (depth to top)
3" Stainless Steel
(size) (material) .010

(6) pump 3 HP 50
(HP) (yield gpm)
220 V 1Ø
(type power)

(7) electric log No
(yes or no)

(organization running log)

(8) how well bottom plugged
3" Backwash Check

description of formations encountered	from	to
Sand Surface	0	25
Thin Clay + Sea Shells	25	72
Blue Clay	72	197
Sand	197	200
Blue Clay	200	208
Sand	208	227
Blue Clay	227	305
Fine Sand	305	335
Blue Clay + Sea Shells	335	370
Sand & Clay Breaks	370	425
Blue Clay	425	475
Fine Sand	475	505
Blue Clay	505	575
Sand	575	585
Blue Clay	585	585
Grey Coarse Sand	585	660
		Plus

CODED

MAR 12 1970

MISC. DD. OF

DRILLERS REMARKS:

If well telescopes please sketch and show depths.

GROUND LEVEL

120 FT →

4" Galvanized Pipe

4X 3/8" Ball Reducer


3" Galvanized Pipe

640 ft →

3" X 20 FT
Stainless Steel
500/1000
Underbar Screen

660 ft →

3" Booby Wood Check

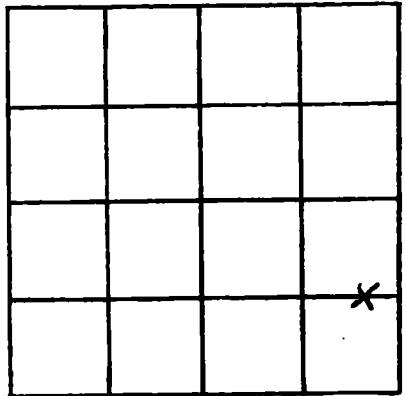

SECTION 32

Please indicate well location X.

ADDITIONAL INFORMATION

If more than one screen, show locations of each on sketch.