

Harrison  
M 350  
2-26-70

MISSISSIPPI  
BOARD OF WATER COMMISSIONERS  
416 North State Street  
Jackson, Mississippi 39201

**CODED**

WATER WELL DRILLERS LOG

2-26 1970 R. J. MOORE HARRISON  
date well completed firm name county well located

LANDOWNER: <u>Howard Hobbs</u>	description of formations encountered	from	to
<u>NORTH BILOXI</u>			
<u>GULFPORT MISS WEST</u> (mailing address) <u>BEACH</u>	<u>TOP SAND</u>	<u>0</u>	<u>10</u>
	<u>RIVER SAND</u>	<u>10</u>	<u>40</u>
	<u>BLUE CLAY</u>	<u>40</u>	<u>282</u>
	<u>BLUE SAND</u>	<u>282</u>	<u>317</u>

WELL LOCATION:  
sec. 8 T 7 N R. 9 E  
1/4 miles of Diberville  
(distance) (direction) (nearest town)

WELL PURPOSE:  
(home) Irrigation, municipal, industrial)

WELL COMPLETION DATA:

(1) diameter (inches) 2"

(2) total depth (feet) 317

(3) static water level (feet) 5 <sup>(below)</sup> above top of ground.

(4) casing GALV, 305,  
(material) (depth)  
(size) If telescope see back.

(5) screen 2x10, 305"  
(length) (depth to top)  
2", SS  
(size) (material)

(6) pump 1HP, 620HP  
(HP) (yield gpm)  
ELCC  
(type power)

(7) electric log \_\_\_\_\_  
(yes or no)  
  
(organization running log)

(8) how well bottom plugged BACK  
WASH VALVE

**CODED**


DRILLERS REMARKS:

MAR 16 1970

MISS. BOD. OF  
WATER COMM.

If well telescopes please sketch and show depths.

GROUND LEVEL

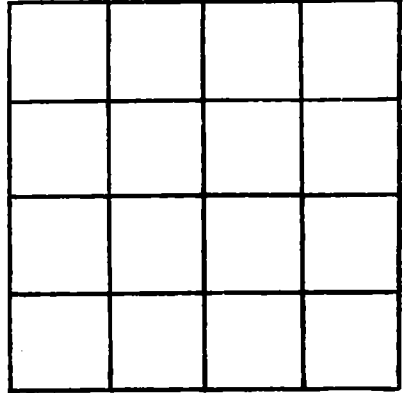

SECTION \_\_\_\_\_

Please indicate well location X.

ADDITIONAL INFORMATION

If more than one screen, show locations of each on sketch.