

E-log #

CODED
CODED

Harrison Co
M 351
4-6-70

MISSISSIPPI
BOARD OF WATER COMMISSIONERS
416 North State Street
Jackson, Mississippi 39201

WATER WELL DRILLERS LOG

4-6 19 70 Laurel Central Company Harrison
date well completed firm name county well located

LANDOWNER:
City of Biloxi
Biloxi, Miss
(mailing address)

WELL LOCATION:
sec. 36 T. 7 S. R. 10 W.
miles (distance) of (direction) of (nearest town)

WELL PURPOSE: Municipal
(home, irrigation, municipal, industrial)

WELL COMPLETION DATA:

(1) diameter (inches) 16"

(2) total depth (feet) 852'

(3) static water level (feet) 30 below above top of ground.

(4) casing Steel 770'
(material) (depth)

16 If telescope see back.
(size) and 63' 98"

(5) screen 50' 796'
(length) (depth to top)

8" Stainless Steel
(size) (material)

(6) pump (HP) (yield gpm)
Electric
(type power)

(7) electric log yes
(yes or no)
Miss. Geol. Survey
(organization running log)

(8) how well bottom plugged Valve

description of formations encountered	from	to
fill	0	3
sand and sea shells	3	52
clay	52	110
shale	110	225
hard shale	225	309
spiky shell	309	336
clay (bumpy)	336	460
sand, s. sh. shale	460	494
clay	494	501
clay & sand streaks	501	596
shaly shale	596	670
sand	670	685
clay & streaks of sand	685	718
sand	718	724
clay and sandy streaks	724	736
light clay	736	760
shale	760	826
sand, shale & lignite	826	829
sand	829	851
shales	851	868

CODED

APR 20 1970

MISS. BLD. OF
WATER COM.


DRILLERS REMARKS:

Pump not set as of this date.

Mailed to Board of Water Commissioners 4/17/70

If well telescopes please sketch and show depths.

GROUND LEVEL

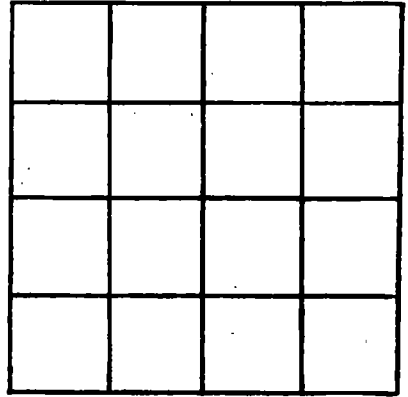

SECTION _____

Please indicate well location X.

ADDITIONAL INFORMATION

If more than one screen, show locations of each on sketch.