

Harrison
M 352
3-26-70

MISSISSIPPI
BOARD OF WATER COMMISSIONERS
416 North State Street
Jackson, Mississippi 39201

CODED

WATER WELL DRILLERS LOG

March-26-1970 McBill Well Works Harrison
date well completed firm name county well located

LANDOWNER: R.B. Ellison
209 OAK Ridge Circle
Big Lake Road
Biloxi, Miss
(mailing address)

description of formations encountered	from	to
Top soil	0'	4'
SAND	4'	30'

WELL LOCATION:
sec. 15 T. 7 N. R. 10 E.
4 miles west of Biloxi
(distance) (direction) (nearest town)

WELL PURPOSE: irrigation
(home, irrigation, municipal, industrial)

- WELL COMPLETION DATA:
- (1) diameter (inches) 1 1/2"
 - (2) total depth (feet) 30'
 - (3) static water level (feet) 4 below above top of ground
 - (4) casing None
(material) (depth)
 - No if telescope see back.
(size)
 - (5) screen 5'
(length) (depth to top)
 - 1 1/2" S.S.
(size) (material)
 - (6) pump 1/2 16
(HP) (yield gpm)
 - Electric
(type power)
 - (7) electric log No
(yes or no)
 - No
(organization running log)
 - (8) how well bottom plugged Best

CODED


APR 10 1970

DRILLERS REMARKS: None

MISS. DEPT. OF WATER

If well telescopes please sketch and show depths.

GROUND LEVEL

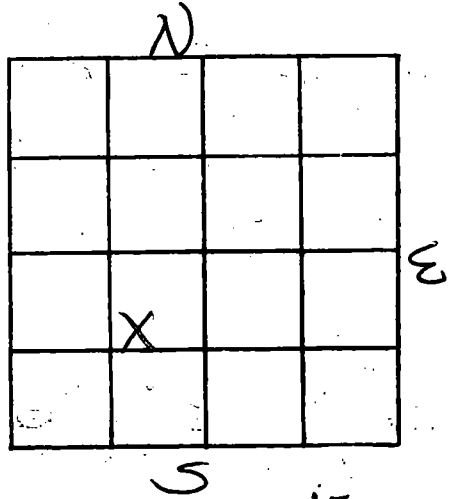

SECTION 15

Please indicate well location X.

ADDITIONAL INFORMATION

If more than one screen, show locations of each on sketch.