

Harrison  
M 353  
4-4-70

MISSISSIPPI  
BOARD OF WATER COMMISSIONERS  
416 North State Street  
Jackson, Mississippi 39201

**CODED**

WATER WELL DRILLERS LOG

April 4, 1970 McBill Well Works HARRISON  
date well completed firm name county well located

LANDOWNER: MRS. Murphy  
2942 Pass Road  
Biloxi, Miss  
(mailing address)

description of formations encountered	from	to
<u>top soil</u>	<u>0'</u>	<u>8'</u>
<u>SAND</u>	<u>8'</u>	<u>30'</u>

WELL LOCATION:  
sec 26 T 1 N R 10 E  
2 miles West of Biloxi  
(distance) (direction) (nearest town)

WELL PURPOSE: IRRIGATION  
(home, irrigation, municipal, industrial)

- WELL COMPLETION DATA:
- (1) diameter (inches) 1/4"
  - (2) total depth (feet) 30'
  - (3) static water level (feet) 4' below above top of ground.
  - (4) casing No No  
(material) (depth)
  - No  
(size) if telescope see back.
  - (5) screen 5'  
(length) (depth to top)
  - 1/4 S.S.  
(size) (material)
  - (6) pump 1/2 18  
(HP) (yield gpm)
  - Electric  
(type power)
  - (7) electric log No  
(yes or no)
  - No  
(organization running log)
  - (8) how well bottom plugged Point

**CODED**


DRILLERS REMARKS: None

APR 10 1970

DRILLER'S ID. NO. OF  
DRILLER'S ORGANIZATION

If well telescopes please sketch and show depths.

GROUND LEVEL

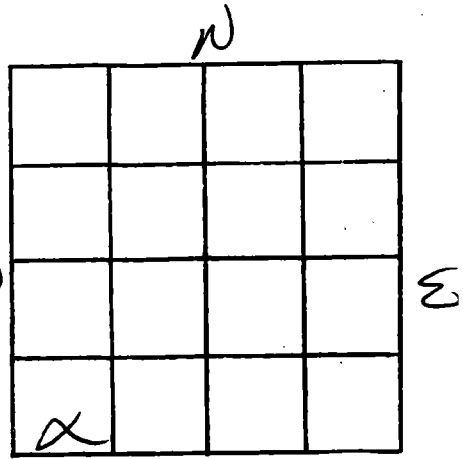

SECTION 26

Please indicate well location X.

ADDITIONAL INFORMATION

If more than one screen, show locations of each on sketch.