

Harrison
M 363
4-17-70

MISSISSIPPI
BOARD OF WATER COMMISSIONERS
416 North State Street
Jackson, Mississippi 39201

COPED

WATER WELL DRILLERS LOG

4/17/70 date well completed
Coastal Drilling Co firm name
Harrison county well located

LANDOWNER: H.S. Oliver
Rt 1 Box 161 C
Dept. Min
(mailing address)

description of formations encountered	from	to
top soil	1	7
white sand	7	22
Blue Clay	22	40
white sand	40	20
more white sand	120	140
Blue Clay	140	350
loam	350	353
Blue Clay	353	418
fine white sand	418	450
more white sand	452	484

WELL LOCATION:
sec. 3 T. 76 R. 10 of 209
2 miles N Landon
(distance) (direction) (nearest town)

WELL PURPOSE: home
(home, irrigation, municipal, industrial)

WELL COMPLETION DATA:


(1) diameter (inches) 2"
(2) total depth (feet) 484
(3) static water level (feet) 24 below top of ground.
(4) casing glass 494 (material) (depth)
(size) If telescope see back.
(5) screen 10' 474 (length) (depth to top)
2" 28 (size) (material)
(6) pump 1/2 14 (HP) (yield/gpm)
5hp (type power)
(7) electric log no (yes or no)
(organization running log)

(8) how well bottom plugged
2 inch water table
DRILLERS REMARKS:
None

MAY 7 1970

If well telescopes please sketch and show depths.

GROUND LEVEL

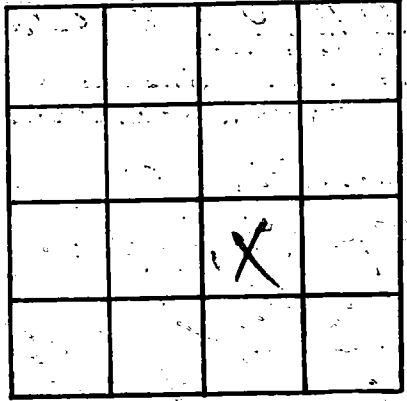

SECTION _____

Please indicate well location X.

ADDITIONAL INFORMATION

Lined area for additional information.

If more than one screen, show locations of each on sketch.