

Harrison
M 365
5-2-70

MISSISSIPPI
BOARD OF WATER COMMISSIONERS
416 North State Street
Jackson, Mississippi 39201

CODED

WATER WELL DRILLERS LOG

5/2/70 date well completed Coastal Drilling firm name Harrison county well located

LANDOWNER: Mr. J.C. Benge
235 Baylane
Biola, Miss
(mailing address)

WELL LOCATION:
sec. 21T 2 N R. 9 E 209
W of W. Ville
(distance) (direction) (nearest town)

WELL PURPOSE: Home
(home, irrigation, municipal, industrial)

WELL COMPLETION DATA:

(1) diameter (inches) 2"

(2) total depth (feet) 347

(3) static water level (feet) 27 below above top of ground.

(4) casing Steel 337
(material) (depth)

 if telescope see back.
(size)

(5) screen 10' 337
(length) (depth to top)

2" SS
(size) (material)

(6) pump 1 18
(HP) (yield gpm)

Sh
(type power)

(7) electric log No
(yes or no)

(organization running log)

description of formations encountered	from	to
Blue Clay	1	15
white sand	15	31
Blue Clay	31	117
Silt Sand	117	124
Blue white clay	124	198
Silt Sand	198	220
Blue Clay	220	318
fine water sand	318	340
Coarse water sand	340	347

(8) how well bottom plugged 2 inch wash stone


DRILLERS REMARKS: None

MAY 7 1970

MISS. BD. OF
WATER COMM.

If well telescopes please sketch and show depths.

GROUND LEVEL

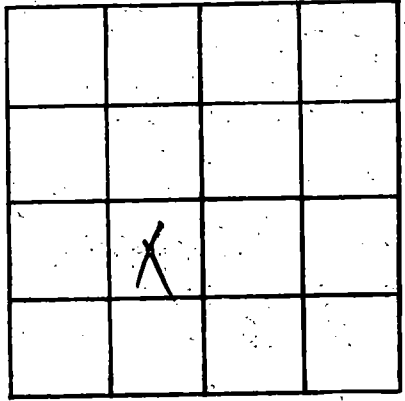

SECTION _____

Please indicate well location X.

ADDITIONAL INFORMATION

If more than one screen, show locations of each on sketch.