

Harrison
 M 368
 5-2-70

MISSISSIPPI
 BOARD OF WATER COMMISSIONERS
 416 North State Street
 Jackson, Mississippi 39201

CODED

3RD WATER WELL DRILLERS LOG
 5/2 19 20 Coastal Well Co. Haines
 date well completed firm name county well located

LANDOWNER: J.B. Brandy
 235 Byrd Ave
 W Biloxi, Miss
 (mailing address)

description of formations encountered	from	to
top soil	1	7
White Sand	7	63
Shell	63	70
Blue Clay	70	200
hard Blue Clay	200	265
Blue Clay	265	300
Shell	300	307
hard Blue Clay	307	322
fine white sand	322	335
Coarse white sand	335	347

WELL LOCATION:
 sec. 9 T. 7 S. R. 9 E 209
 Waverly
 (distance) (direction) (nearest town)

WELL PURPOSE: home
 (home, irrigation, municipal, industrial)

WELL COMPLETION DATA:
 (1) diameter (inches) 2"
 (2) total depth (feet) 347'
 (3) static water level (feet) 37' below top of ground.
 (4) casing glass 337' (material) (depth)
 (size) if telescope see back.
 (5) screen 10' 337' (length) (depth to top)
 2" 25' (size) (material)
 (6) pump 1 HP 20 (type power) (yield gpm)
 Ele
 (7) electric log No (yes or no)
 (organization running log)


(8) how well bottom plugged
 2" packed with shale
 DRILLERS REMARKS: None

JUN 11 1970

MISS. BD. OF
 WATER COMM

If well telescopes please sketch and show depths.

GROUND LEVEL

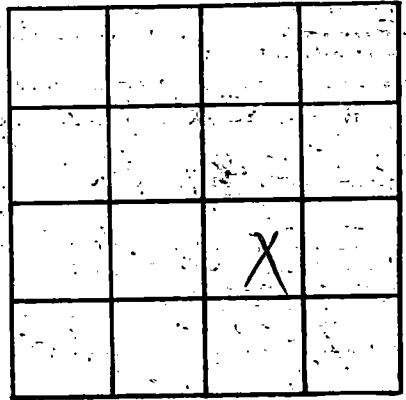

SECTION _____

Please indicate well location X.

ADDITIONAL INFORMATION

If more than one screen, show locations of each on sketch.