

Harrison  
M 370  
5-25-70

MISSISSIPPI  
BOARD OF WATER COMMISSIONERS  
416 North State Street  
Jackson, Mississippi 39201

CODED

WATER WELL DRILLERS LOG

5/25/70 <sup>3</sup> ec date well completed  
Central Utility Co. firm name  
Harrison county well located

LANDOWNER: Sherwood  
Tuler Park  
Rt 2 W Biloxi Miss  
(mailing address)

description of formations encountered	from	to
Top Soil	1	5
Sugar Sand	5	23
Blue Clay	23	45
Coarse white sand	45	110
Sugar Sand	110	118
Blue Clay	118	286
fine white sand	286	300
hard blue clay	300	310
fine white sand	310	360
Blue Clay	360	398
hard blue clay	398	425
fine white sand	425	435
Coarse white sand	435	477

WELL LOCATION:  
sec 18 T 76 R 9 S 29  
2.7 miles NW of Biloxi  
(distance) (direction) (nearest town)

WELL PURPOSE: water  
(home, irrigation, municipal, industrial)

WELL COMPLETION DATA:  
(1) diameter (inches) 4"  
(2) total depth (feet) 477'  
(3) static water level (feet) 52' below top of ground  
(4) casing glau 457'  
(material) (depth)  
(size) if telescope see back.  
(5) screen 20' 457'  
(length) (depth to top)  
2" SS.  
(size) (material)  
(6) pump 5 HP 600  
(HP) (yield gpm)  
Ele  
(type power)  
(7) electric log no  
(yes or no)  
(organization running log)


(8) how well bottom plugged  
4" back with water  
DRILLERS REMARKS:  
None

JUN 11 1970

MISS. BD. OF  
WATER

If well telescopes please sketch and show depths.

GROUND LEVEL

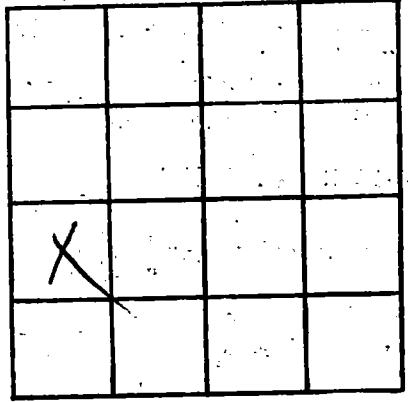

SECTION \_\_\_\_\_

Please indicate well location X.

ADDITIONAL INFORMATION

If more than one screen, show locations of each on sketch.