

Harrison  
 M371  
 5-30-70

MISSISSIPPI  
 BOARD OF WATER COMMISSIONERS  
 416 North State Street  
 Jackson, Mississippi 39201

**CODED**

WATER WELL DRILLERS LOG

8/30 1970 <sup>3</sup> CA Coastal Drilling Co. Harrison  
 date well completed firm name county well located

LANDOWNER: H.A. Davis  
 Rt 1 Box 109  
 Biloxi, Miss  
 (mailing address)

description of formations encountered	from	to
top soil	1	6
white sand	6	20
glau	20	34
blue clay	34	204
fine white sand	204	230
blue clay	230	265
coarse white sand	265	295

WELL LOCATION:  
 sec. 5 T. 2 R. 9 <sup>209</sup>  
2 miles N of Biloxi  
 (distance) (direction) (nearest town)

WELL PURPOSE: home  
 (home, irrigation, municipal, industrial)

WELL COMPLETION DATA:  
 (1) diameter (inches) 2"  
 (2) total depth (feet) 295  
 (3) static water level (feet) 32' below above top of ground.  
 (4) casing glau 285  
 (material) (depth)  
 (size) if telescope see back.  
 (5) screen 10' 285  
 (length) (depth to top)  
2" SS.  
 (size) (material)  
 (6) pump 1 1/2 19  
 (HP) (yield gpm)  
Ele  
 (type power)  
 (7) electric log no  
 (yes or no)  
 (organization running log)


(8) how well bottom plugged  
~~2' of fine white sand~~  
 DRILLERS REMARKS:  
very good well

JUN 11 1970

MISS. BD. OF  
 WATER COMM.

If well telescopes please sketch and show depths.

GROUND LEVEL

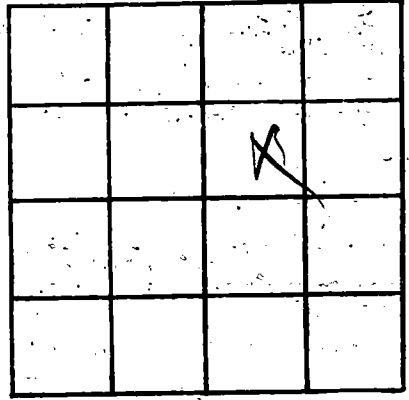

SECTION \_\_\_\_\_

Please indicate well location X.

ADDITIONAL INFORMATION

If more than one screen, show locations of each on sketch.