

Harrison  
 M-24378  
 7-67

MISSISSIPPI  
 BOARD OF WATER COMMISSIONERS  
 416 North State Street  
 Jackson, Mississippi 39201

**CODED**

WATER WELL DRILLERS LOG

July 1967 M&B Drilling Co. Harrison  
 date well completed firm name county well located

LANDOWNER:  
 Community Water System  
 DeBerville, Miss  
 (mailing address)


WELL LOCATION:  
 sec. 21 T. 9 N. R. 9 E  
 Corner Gore Rd & Old Hwy 90  
 (distance) miles (direction) of (nearest town)

WELL PURPOSE: 20 Homes  
 (home, irrigation, municipal, industrial)

WELL COMPLETION DATA:  
 (1) diameter (inches) 4X2  
 (2) total depth (feet) 815  
 (3) static water level (feet) 4 below top of ground  
 (4) casing Galv. Steel 795 (material) (depth)  
 4X2 if telescope see back.  
 (5) screen 20 FT. 795 (length) (depth to top)  
 2" 5 Tanks Steel #10 (size) (material) Under-bar  
 (6) pump 2 30 (HP) (yield gpm)  
 220V 10 (type power)  
 (7) electric log No (yes or no)  
 Submersible Pump - Reda (organization running log)  
 (8) how well bottom plugged 2" Back Wash Chk

description of formations encountered	from	to
Surface Clay	0	10
White Clay	10	18
Dark Grey Clay	18	22
Sand & Clay Breaks	22	26
Grey Clay	26	50
Fine Grey Silt & Clay Breaks	50	105
Blue Clay	105	120
Sand & Clay Breaks	120	165
Cherty Sand	165	260
Will make wells		
Blue Clay	260	270
Sand	270	425
Blue Clay	425	450
Sand	450	470
Blue Clay	470	515
Circulation loss		
Sand	515	530
Blue Clay	530	550
Sand	550	605
Blue Clay	605	622
Sand	622	685
Blue Clay	685	705
Sand	705	725
Blue Clay	725	750
Fine Sand	750	815
Good Sand	815	
Still cutting sand at 815 Feet		

**CODED**

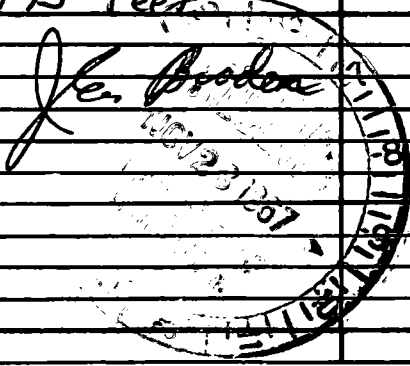

DRILLERS REMARKS:  
 Pump set 60 FT

