

Harrison
M385
6-10-70

MISSISSIPPI
BOARD OF WATER COMMISSIONERS
416 North State Street
Jackson, Mississippi 39201

WATER WELL DRILLERS LOG

6/10/70 19 Coastal Drilling Co. Harrison
date well completed firm name county well located

LANDOWNER: Louis Lee
Rt 2 Box 440
Bilboe, Miss
(mailing address)

WELL LOCATION:
sec. 13 T. 2 N. R. 10 E.
Radix site
(distance) (direction) of (nearest town)

WELL PURPOSE: home
(home, irrigation, municipal, industrial)

WELL COMPLETION DATA:
(1) diameter (inches) 2 x 4
(2) total depth (feet) 392
(3) static water level (feet) 22' below above top of ground.
(4) casing galv 377
(material) (depth)
2 x 4 If telescope see back.
(size)
(5) screen 15' 377
(length) (depth to top)
2" SS
(size) (material)
(6) pump 3/4 22
(HP) (yield gpm)
Ele
(type power)
(7) electric log no
(yes or no)
(organization running log)

description of formations encountered	from	to
top soil	1	4
clay	4	12
Coarse white sand	12	27
glauv	27	34
Coarse sand	34	50
fine water sand	50	70
hard blue clay	70	220
fine water sand	220	235
Coarse water sand	235	239
hard blue clay	239	354
fine water sand	354	370
Coarse water sand	370	392

(8) how well bottom plugged
2 inch water valve
DRILLERS REMARKS:
None

JUL 14 1970

MISS. Bd. OF
WATER COMM.


If well telescopes please sketch and show depths.

GROUND LEVEL

4" Casing 144'

2" Casing 248'

15' 2" SS Screen

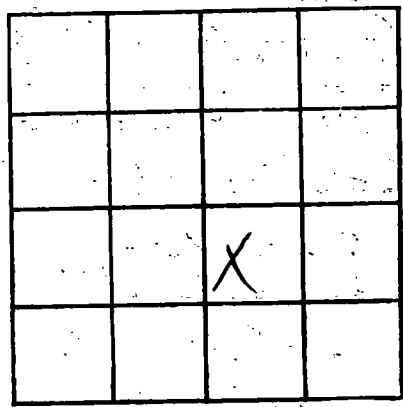

SECTION _____

Please indicate well location X.

ADDITIONAL INFORMATION

If more than one screen, show locations of each on sketch.