

Harrison
M387
6-16-70

MISSISSIPPI
BOARD OF WATER COMMISSIONERS
416 North State Street
Jackson, Mississippi 39201

WATER WELL DRILLERS LOG

June 16 1970 M & B Drilling Co. Harrison
date well completed firm name county well located

LANDOWNER: V. M. Mannino
West Beach Edgewater Pk.
Miss.
(mailing address)

WELL LOCATION:
sec. 34 T. 7 N R. 10 E
- miles - of Edgewater Park
(distance) (direction) (nearest town)

WELL PURPOSE: Apartment
(home, irrigation, municipal, industrial)

WELL COMPLETION DATA:
(1) diameter (inches) 4 X 2
(2) total depth (feet) 620
(3) static water level (feet) 265 below top of ground.
(4) casing Galvanized Pipe - 610
(material) (depth)
4 X 2 if telescope see back.
(size)
(5) screen 10 FT, 610
(length) (depth to top)
2 1/2", Stainless Steel .010
(size) (material)
(6) pump 2 205
(HP) (yield gpm)
200 K 10 Submersible
(type power)
(7) electric log _____
(yes or no)
USGS - Tried - Bob Moching Operator
(organization running log)
(8) how well bottom plugged Back
Wash Check

description of formations encountered	from	to
Sand	0	25
Blue Clay	25	35
Shale & Blue Clay	35	40
Black Muck	40	65
Gray Clay	65	80
Sandstone	80	92
Blue Clay	92	103
Sand	103	108
Blue Clay	108	208
Sand	208	218
Blue Clay	218	340
Swamp	340	355
Sand	355	370
Blue Clay	370	575
Sand	575	622
Blue Clay	622	630+

JUL 9 1970

MISS. BD. OF
WATER COMM.

DRILLERS REMARKS:

If well telescopes please sketch and show depths.

GROUND LEVEL

136 →

4" Polvinyl

260 →


2" Polvinyl

10 FT 2 1/2" S.W. .010

600 →

10 FT Tailpipe

2 1/2" Back Wash Valve

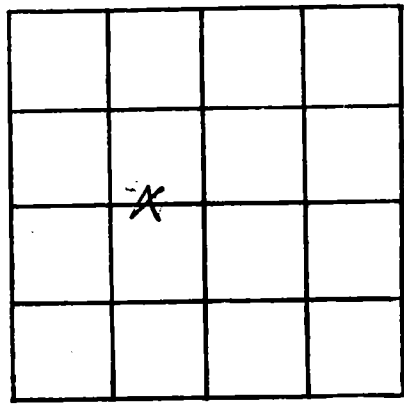

SECTION 34

Please Indicate well location X.

ADDITIONAL INFORMATION

If more than one screen, show locations of each on sketch.