

HARRISON  
M388  
8-22-70

MISSISSIPPI  
BOARD OF WATER COMMISSIONERS  
416 North State Street  
Jackson, Mississippi 39201

**CODED**

WATER WELL DRILLERS LOG

8/22/70 Coastal Drilling Harris  
date well completed firm name county well located

LANDOWNER LW Austin  
RT 1, Box 193  
Wilcox, Miss  
(mailing address)

description of formations encountered	from	to
Top Soil	1	3
Red Clay	3	8
slimest	8	14
White Sand	14	24
hard Blue Sand	24	304
Fine water Sand	304	314
Coarse water Sand	314	318
fine water Sand	318	325
hard water Sand	325	340
Coarse water Sand	340	378

WELL LOCATION:  
sec. 13 T 7 N R 10 W  
Road 5 miles  
(distance) (direction) (nearest town)

WELL PURPOSE: house  
(home, irrigation, municipal, industrial)

- WELL COMPLETION DATA:
- (1) diameter (inches) 2"
  - (2) total depth (feet) 378
  - (3) static water level (feet) 21 below top of ground.
  - (4) casing glau 368  
(material) (depth)  
(size) If telescope see back.
  - (5) screen 10' 368  
(length) (depth to top)  
29 SS  
(size) (material)
  - (6) pump 1 HP 17  
(HP) (yield gpm)  
5hp  
(type power)
  - (7) electric log no  
(yes or no)
- (organization running log)

**CODED**

(8) how well bottom plugged  
2" hard wood vats


SEP 30 1970

DRILLERS REMARKS:  
None

MISS. BD. OF  
WATER COMM.

If well telescopes please sketch and show depths.

GROUND LEVEL

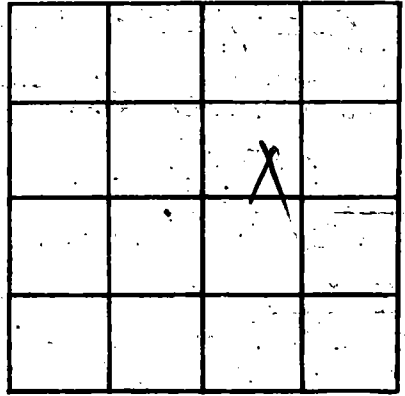

SECTION \_\_\_\_\_

Please indicate well location X.

ADDITIONAL INFORMATION

If more than one screen, show locations of each on sketch.