

MISSISSIPPI
BOARD OF WATER COMMISSIONERS
416 North State Street
Jackson, Mississippi 39201

CODED

WATER WELL DRILLERS LOG

HARRISON

M 391

9-19-70

9-19-70
date well completed

Coastal Builders & Home
firm name

county well located

LANDOWNER: T. B. Richards

Rt 1 Box 119C

Biloxi, Miss
(mailing address)

WELL LOCATION:

sec. 3 T 7 N R 10 E
5 miles E Waplesville
(distance) (direction) (nearest town)

WELL PURPOSE: home
(home, irrigation, municipal, industrial)

WELL COMPLETION DATA:

- (1) diameter (inches) 2"
- (2) total depth (feet) 205
- (3) static water level (feet) 22 below top of ground
- (4) casing 5" galv. 195
(material) (depth)
(size) If telescope see back.
- (5) screen 10' 195
(length) (depth to top)
2" 52
(size) (material)
- (6) pump 1 HP 17
(HP) (yield gpm)
Elec
(type power)
- (7) electric log No
(yes or no)
(organization running log)

(8) how well bottom plugged
2' laborer drilled

DRILLERS REMARKS:

None

description of formations encountered

from to

description of formations encountered	from	to
top soil	1	5
red clay	5	13
white sand	13	37
blue clay	37	124
fine water sand	124	137
hard clay	137	150
fine water sand	150	167
fine water sand	167	205


CODED

SEP 30 1970

MISS. Bd. OF
WATER COMMISSIONERS

If well telescopes please sketch and show depths.

GROUND LEVEL

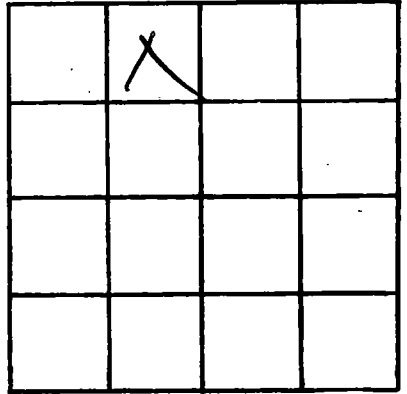

SECTION _____

Please indicate well location X.

ADDITIONAL INFORMATION

If more than one screen, show locations of each on sketch.