

HARRISON  
M 393  
9-7-70

MISSISSIPPI  
 BOARD OF WATER COMMISSIONERS  
 416 North State Street  
 Jackson, Mississippi 39201  
**WATER WELL DRILLERS LOG**

**CODED**

9-7-1970 C.T. Switzer Well Co. HARRISON  
 date well completed firm name county well located

LANDOWNER: RAIPH Borries  
off  
GAY Road, Rt 2 Box 336  
Biloxi, Miss.  
 (mailing address)

WELL LOCATION:  
 sec 8 T 7 S R 9 W  
4 miles N of BILOXI  
 (distance) (direction) (nearest town)

WELL PURPOSE: Home  
 (home, irrigation, municipal, industrial)

WELL COMPLETION DATA:

(1) diameter (inches) 2 1/2

(2) total depth (feet) 800'

(3) static water level (feet) 20' below above top of ground.

(4) casing galv. 800'  
 (material) (depth)  
 (size) if telescope see back.

(5) screen 10' 790'  
 (length) (depth to top)  
008 Stainless steel  
 (size) (material)

(6) pump \_\_\_\_\_ (HP) \_\_\_\_\_ (yield gpm)  
NO PUMP  
 (type power)

(7) electric log \_\_\_\_\_ (yes or no)  
 (organization running log)

(8) how well bottom plugged back  
pressure valve

description of formations encountered	from	to
CLAY	0	10
SAND	10	21
CLAY	21	41
SAND	41	61
Mixed	61	81
CLAY	81	140
SAND, fair	140	160
SAND, good	160	180
CLAY	180	199
Mixed	199	219
CLAY	219	238
Mixed	238	258
CLAY	258	277
Mixed	277	297
SAND	297	307
CLAY	307	357
SAND, good	357	375
CLAY	375	456
SHAIL + CLAY	456	476
SHAIL	476	496
Mixed	496	516
SAND, fine	516	536
SAND, fair	536	546
CLAY	546	575
SHAIL	575	595
CLAY	595	756
SAND	756	800


**CODED**

OCT 17 1970

DRILLERS REMARKS: \_\_\_\_\_  
 \_\_\_\_\_  
 MISS. BD. OF WATER COMM.

If well telescopes please sketch and show depths.

GROUND LEVEL

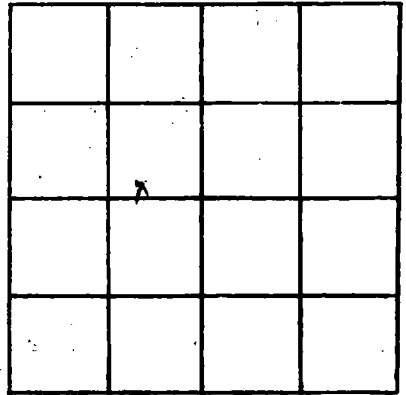

SECTION 8

Please indicate well location X.

ADDITIONAL INFORMATION

If more than one screen, show locations of each on sketch.