

HARRISON
M 396
3-23-72

MISSISSIPPI
 BOARD OF WATER COMMISSIONERS
 416 North State Street
 Jackson, Mississippi 39201

WATER WELL DRILLERS LOG

CODED

3/23/72 19 Central Drilling Co. Harrison
 (date well completed) (firm name) (county well located)

LANDOWNER C. W. Dammitt
Rt 1
Biloxi, Missis
 (mailing address)

description of formations encountered	from	to
Top Soil	1	3
Red Clay	3	18
White Sand	18	35
Blue Clay	35	290
fine water sand	290	305
Weymouth Blue Clay	305	440
fine water sand	440	460
Coarse water sand	460	504

WELL LOCATION:
 sec. 9 T. 7 N. R. 10 E
0.9 miles South Ospreyville
 (distance) (direction) (nearest town)

WELL PURPOSE: home
 (home, irrigation, municipal, industrial)

WELL COMPLETION DATA:
 (1) diameter (Inches) 4 1/2"
 (2) total depth (feet) 504'
 (3) static water level (feet) 20 below top of ground.
 (4) casing glav. 489' (material) (depth)
4 1/2" (size) If telescope see back.
 (5) screen 15' 489' (length) (depth to top)
2" (size) SS (material)
 (6) pump One (HP) 19 (yield gpm)
Ele (type power)
 (7) electric log No (yes or no)
 (organization running log)

CODED

(8) how well bottom plugged 2'
Next Week Water
 DRILLERS REMARKS: Very good well

6 1972

If well telescopes please sketch and show depths.

0000

GROUND LEVEL



147' 4" galv
 casing




342' 2" galv
 casing



0000

15' 2" 555
 casing

2" back wash valve

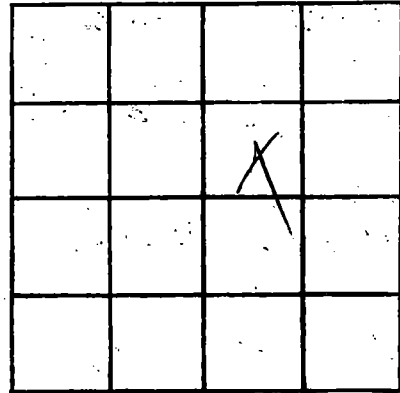

SECTION _____

Please indicate well location X.

ADDITIONAL INFORMATION

Lined area for additional information.

If more than one screen, show locations of each on sketch.