

HARRISON
M397
5-17-71

MISSISSIPPI
BOARD OF WATER COMMISSIONERS
416 North State Street
Jackson, Mississippi 39201

ELOG #83

Page 1
CODED

WATER WELL DRILLERS LOG

5-17 1971 Switzer Well Co. Harrison
date well completed firm name county well located

LANDOWNER	description of formations encountered	from	to
Gulf Thomas Water Corp	top soil	0	1
1040 Ford (Hondabero)	Sand	1	36
Gulfport, Miss.	CLAY	36	41
(mailing address)	SAND	41	61
WELL LOCATION:	CLAY	61	141
sec 32 T 7 R 12 S W	SAND	141	146
IN FERRYWOOD COMMUNITY, GULFPORT	CLAY	146	166
(distance) miles (direction) of (nearest town)	Mixed	165	179
WELL PURPOSE: <u>Subdivision</u>	CLAY	179	184
(home, irrigation, municipal, industrial)	Sand	184	199
WELL COMPLETION DATA:	CLAY	199	315
(1) diameter (inches) <u>8"</u>	Sand	315	318
(2) total depth (feet) <u>830'</u>	Mixed	318	338
(3) static water level (feet) <u>18'</u> ^{below} / _{above} top of ground.	CLAY	338	358
(4) casing <u>black pipe</u> <u>830'</u> (material) (depth)	Mixed	358	378
<u>12"</u> If telescope see back. (size)	CLAY	378	398
(5) screen <u>10</u> <u>770</u> (length) (depth to top)	SAND	398	408
<u>010</u> (size) <u>Stainless steel</u> (material)	Streaks	408	418
(6) pump <u>40</u> <u>300</u> (HP) (yield gpm)	CLAY	418	458
<u>ELECT</u> (type power)	CLAY + shell	458	478
(7) electric log <u>YES</u> (yes or no)	CLAY	478	482
<u>Miss Geo. Skaney</u> (organization running log)	SAND	482	492
(8) how well bottom plugged <u>METZ</u> <u>BE-KWASH VALVE</u>	CLAY	492	497
DRILLERS REMARKS:	shell	497	517
	CLAY	517	557
	CLAY + shell	557	597
	SAND	597	614
	CLAY	614	617
	SAND	617	620
	CLAY	620	627
	SAND	627	637
	CLAY	637	640
	SAND	640	687
	shell	687	696
	CLAY	696	715
	CLAY + shell	715	735
	CLAY	735	745
	SAND	745	755
	CLAY	755	771
	Sand fine	771	774
	Sand good	774	834

CODED

JUN 23 1971

cont. on page 2


If well telescopes please sketch and show depths.

GROUND LEVEL

300' 05 12"

370' 05 8"

60' 05
9" SCREEN

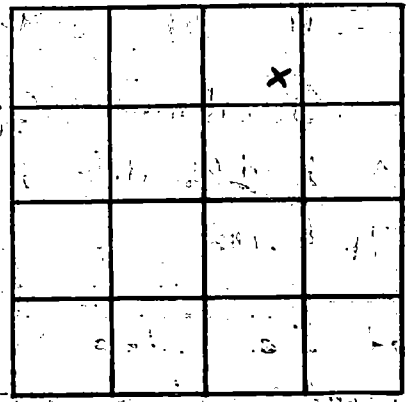

SECTION 32

Please indicate well location X.

ADDITIONAL INFORMATION

Clay	834 - 963
Sand	963 - 1006
Clay	1006 - 1034

Well set at 830 feet

If more than one screen, show locations of each on sketch.