

HARRISON
M 400
1-13-72

MISSISSIPPI
BOARD OF WATER COMMISSIONERS
416 North State Street
Jackson, Mississippi 39201

CODED

WATER WELL DRILLERS LOG


1/13/72 date well completed
Crestal Valley Co. firm name
Harrison county well located

| LANDOWNER | description of formations encountered | from | to |
|--------------------------------|---------------------------------------|------|-----|
| Morgan Jones | Top Soil | 5 | 5 |
| Big Ridge Rd (mailing address) | Red Clay | 5 | 15 |
| | White Sand | 15 | 35 |
| | Flint | 35 | 38 |
| | Blue Clay | 38 | 200 |
| | fine water sand | 200 | 220 |
| | Rock | 220 | 221 |
| | hard blue clay | 221 | 310 |
| | fine water sand | 310 | 325 |
| | course water sand | 325 | 350 |

WELL LOCATION:
sec. 9 T 7 N R. 9 E S
One (1) miles N of Huchins (distance) (direction) (nearest town)
WELL PURPOSE: home (home, irrigation, municipal, industrial)
WELL COMPLETION DATA:
(1) diameter (inches) 2"
(2) total depth (feet) 360
(3) static water level (feet) 60' below top of ground.
(4) casing 350 (material) (depth)
(size) If telescope see back.
(5) screen 18' 350 (length) (depth to top)
2" 58 (size) (material)
(6) pump 13 (HP) (yield gpm)
(type power)
(7) electric log Yes (yes or no)
(organization running log)

CODED

(8) how well bottom plugged 3"
back with stable
DRILLERS REMARKS: none

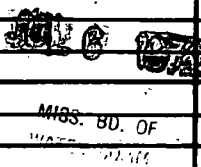


MISS. BD. OF
WATER COMMISSIONERS

If well telescopes please sketch and show depths.

01000

GROUND LEVEL

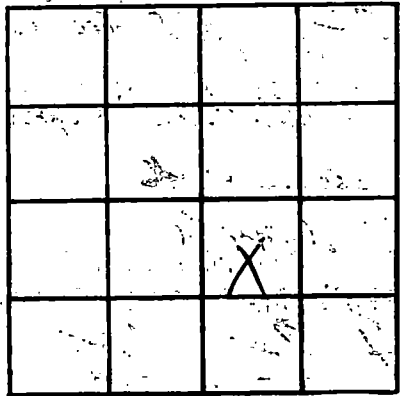

SECTION _____

Please indicate well location X.

ADDITIONAL INFORMATION

Multiple horizontal lines for additional information.

01000

If more than one screen, show locations of each on sketch.