

HARRISON
M 401
11-13-70

MISSISSIPPI
 BOARD OF WATER COMMISSIONERS
 416 North State Street
 Jackson, Mississippi 39201
 WATER WELL DRILLERS LOG

CODED

11-13 1970 Q.T. Switzer Well Co. HARRISON
 date well completed firm name county well located

LANDOWNER: W.P. Stevens
102 Pine Grove
Biloxi, Miss. 39531
 (mailing address)

WELL LOCATION:
 sec. 34 T. 7 S. R. 10 W.
IN city miles (distance) RS (direction) Biloxi (nearest town)

WELL PURPOSE: home
 (home, irrigation, municipal, industrial)

WELL COMPLETION DATA:
 (1) diameter (inches) 2"
 (2) total depth (feet) 468'
 (3) static water level (feet) 18' below top of ground.
 (4) casing galv. (material) 468' (depth)
 (size) If telescope see back.
 (5) screen 10' (length) 458' (depth to top)
008 (size) (material)
 (6) pump 1/2 (owners pump) 1/2 (material) 9 1/2 (yield gpm)
 (HP) (type power)
ELECT
 (type power)
 (7) electric log NO (yes or no)
 (organization running log)
 (8) how well bottom plugged back
pressure valve

description of formations encountered	from	to
SAND	0	39
CLAY, SOFT	39	60
SAND	60	75
CLAY	75	80
SAND	80	95
CLAY	95	117
SAND	117	120
CLAY	120	190
SAND	190	199
CLAY	199	202
SAND	202	215
CLAY	215	358
SAND, fine	358	377
CLAY	377	432
SAND, good	432	467


CODED

DEC 17 1970

DRILLERS REMARKS:

If well telescopes please sketch and show depths.

GROUND LEVEL

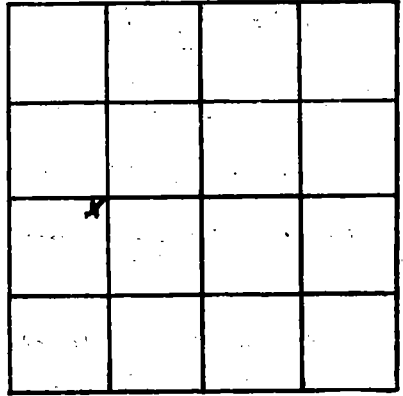

SECTION 34

Please indicate well location X.

ADDITIONAL INFORMATION

If more than one screen, show locations of each on sketch.