

HARRISON  
M 402  
11-20-70

MISSISSIPPI  
 BOARD OF WATER COMMISSIONERS  
 416 North State Street  
 Jackson, Mississippi 39201  
 WATER WELL DRILLERS LOG

**CODED**

11-20-1970 date well completed      CT Switzer Well Co. firm name      HARRISON county well located

LANDOWNER: Mr. Myrtle Walker  
2310 29th St.  
Gulfport, Miss.  
 (mailing address)

WELL LOCATION:  
 sec. 17 T. 7 S. R. 10 W.  
2 miles N of Handshoe  
 (distance) (direction) (nearest town)

WELL PURPOSE: Home  
 (home, irrigation, municipal, industrial)

WELL COMPLETION DATA:  
 (1) diameter (inches) 2"  
 (2) total depth (feet) 520'  
 (3) static water level (feet) -9' below top of ground.  
 (4) casing galv. 520'  
       (material) (depth)  
       (size) if telescope see back.  
 (5) screen 10' 510'  
       (length) (depth to top)  
       008, stainless steel  
       (size) (material)  
 (6) pump 1 13  
       (HP) (yield gpm)  
       Electric  
       (type power)  
 (7) electric log N  
       (yes or no)  
       (organization running log)  
 (8) how well bottom plugged back  
       pressure valve

description of formations encountered	from	to
CLAY	0	39
SAND	39	81
CLAY	81	119
SAND	119	139
CLAY	139	194
SAND	194	207
CLAY	207	293
SAND	293	303
CLAY	303	418
SHALE	418	437
CLAY	437	447
SAND, fair	447	497
SAND, good	497	520


**CODED**

DEC 17 1970

DRILLERS REMARKS:

If well telescopes please sketch and show depths.

GROUND LEVEL

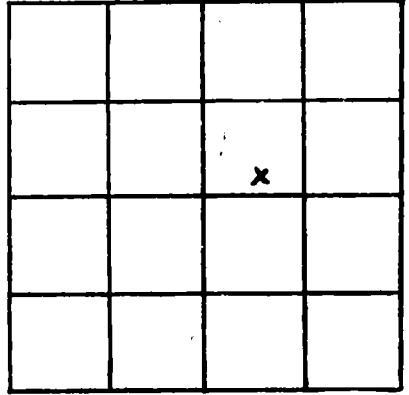

SECTION 17

Please indicate well location X.

ADDITIONAL INFORMATION

If more than one screen, show locations of each on sketch.