

HARRISON
M 404
12-3-70

MISSISSIPPI
 BOARD OF WATER COMMISSIONERS
 416 North State Street
 Jackson, Mississippi 39201

WATER WELL DRILLERS LOG

CODED

~~12-3-70~~ DEC 17 1970 C.T. Switzer Well Co. HARRISON
 date well completed firm name county well located

LANDOWNER: Bayou Oak Mobile
PARK
MAGNOIA Street
GUIFPORT, Miss.
 (mailing address)

WELL LOCATION:
 sec. 29 T. 7 S. R. 12 W.
0.8 miles W of B. Oak
 (distance) (direction) (nearest town)

WELL PURPOSE: FLR. PARK
 (home, irrigation, municipal, industrial)

WELL COMPLETION DATA:

(1) diameter (inches) 4"

(2) total depth (feet) 820'

(3) static water level (feet) -27' below
 top of ground.

(4) casing BLACK PIPE P20'
 (material) (depth)
6x4 if telescope see back.
 (size)

(5) screen 40' 780'
 (length) (depth to top)
008 STAINLESS STEEL
 (size) (material)

(6) pump 7 1/2 125
 (HP) (yield gpm)
ELECTRIC
 (type power)

(7) electric log NO
 (yes or no)
 (organization running log)

(8) how well bottom plugged back
pressure valve

description of formations encountered	from	to
	0	20
SAND	0	20
CLAY	20	60
SAND	60	75
CLAY	75	80
SAND & gravel	80	97
CLAY	97	117
mixed	117	137
CLAY	137	157
SAND streak	157	177
CLAY	177	216
Mixed	216	236
SAND	236	279
CLAY	279	295
CLAY + shale	295	314
CLAY	314	353
Streaks	353	413
CLAY	413	492
Shale	492	512
Shale & shale	512	531
Sand, good	531	571
CLAY	571	610
Shale	610	650
CLAY	650	689
CLAY + shale	689	709
CLAY	709	721
Sand, fine	721	769
Sand, good	769	820


CODED

DEC 17 1970

DRILLERS REMARKS: _____ MISS. BD. OF WATER COMM.

If well telescopes please sketch and show depths.

GROUND LEVEL

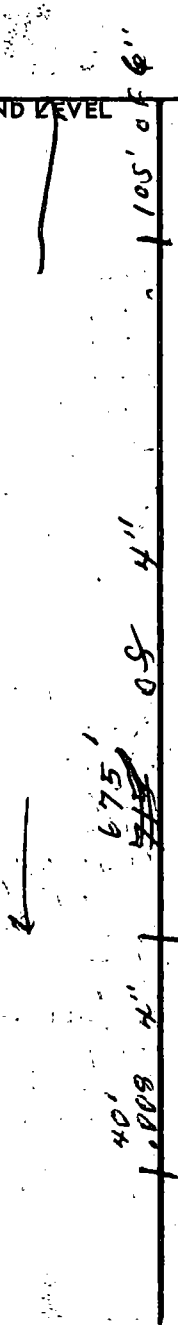

*			

SECTION 29

Please indicate well location X.

ADDITIONAL INFORMATION

If more than one screen, show locations of each on sketch.