

MISSISSIPPI
BOARD OF WATER COMMISSIONERS
416 North State Street
Jackson, Mississippi 39201

CODED

WATER WELL DRILLERS LOG

HARRISON
M410
12-12-70

12/12/70 19 Central Drilling Co. Hannon
date well completed firm name county well located

LANDOWNER: Miss Hester
Rt 6 Box 384 D
Bibi Min
(mailing address)

description of formations encountered	from	to
<u>Top Soil</u>	<u>1</u>	<u>4</u>
<u>Red Clay</u>	<u>4</u>	<u>9</u>
<u>White Sand</u>	<u>19</u>	<u>24</u>
<u>Silt</u>	<u>24</u>	<u>40</u>
<u>hard Blue Clay</u>	<u>40</u>	<u>72</u>
<u>Soft Blue Clay</u>	<u>72</u>	<u>200</u>
<u>Red Blue Clay</u>	<u>200</u>	<u>285</u>
<u>fine water sand</u>	<u>285</u>	<u>310</u>
<u>Coarse water sand</u>	<u>310</u>	<u>349</u>

WELL LOCATION:
sec. 9 T. 2 N. R. 9 E.
S. W.
North Bibi
(distance) miles (direction) (nearest town)

WELL PURPOSE: home
(home, irrigation, municipal, industrial)

WELL COMPLETION DATA:

(1) diameter (inches) 2"

(2) total depth (feet) 349

(3) static water level (feet) 38 below above top of ground.

(4) casing Galv. 339
(material) (depth)

(size) if telescope see back.

(5) screen 10' 339
(length) (depth to top)

2" SS
(size) (material)

(6) pump One 17
(HP) (yield gpm)

Ele
(type power)

(7) electric log Yes
(yes/no)

(organization running log)

CODED

JAN 13 1971

(8) how well bottom plugged 3' back with Helix



MISS. ED. OF
WATER COMMISSIONERS

DRILLERS REMARKS:
None

If well telescopes please sketch and show depths.

(Faint, illegible text)

GROUND LEVEL

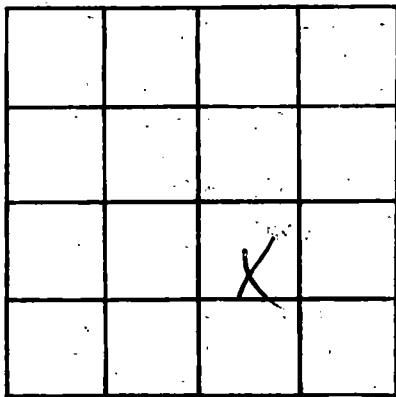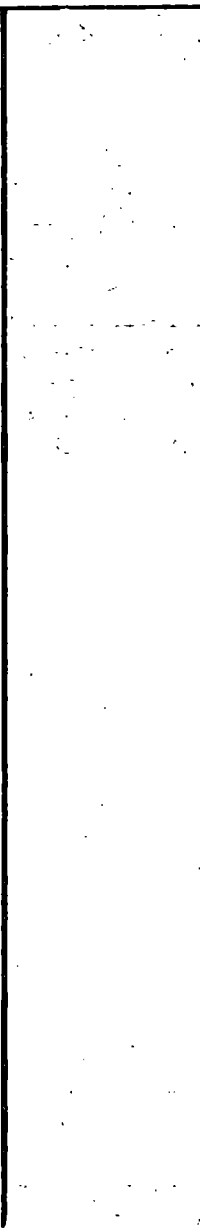

SECTION _____

Please indicate well location X.

ADDITIONAL INFORMATION

Lined area for additional information.

If more than one screen, show locations of each on sketch.