

HARRISON
M411
1-21-70

MISSISSIPPI
BOARD OF WATER COMMISSIONERS
416 North State Street
Jackson, Mississippi 39201
WATER WELL DRILLERS LOG

CODED

Jan. 21 1970 C. T. Switzer Well Co. Harrison
date well completed firm name county well located

LANDOWNER: James S. Shaw
107 Reynoir Rd.
Biloxi, Miss.
(mailing address)

WELL LOCATION:
D'EVERVILLE 7 1/2 miles N of BILCOXI
SOC 22 5 R 9 W
(distance) (direction) (nearest town)

WELL PURPOSE:
(home, irrigation, municipal, industrial)

WELL COMPLETION DATA:
(1) diameter (inches) 2"
(2) total depth (feet) 362'
(3) static water level (feet) 216' below top of ground
(4) casing galv. 362' (material) (depth)
(size) If telescope see back.
(5) screen 10' 352' (length) (depth to top)
.008 STAINLESS STEEL (size) (material)
(6) pump 1/2 HP 75W (HP) (yield gpm)
Electric (type power)
(7) electric log No (yes or no)
(organization running log)
(8) how well bottom plugged back PRESSURE VALVE

description of formations encountered	from	to
clay	0	17
sand	17	38
clay	38	83
sand	83	94
mixed	94	105
clay	105	143
mixed	143	164
clay	164	244
clay mixed	244	265
clay	265	280
sand	280	286
fine sand	286	301
clay	301	344
sand	344	362

CODED


FEB 6 - 1970

MISS. DD. 65
WATER COMM.

DRILLERS REMARKS:

If well telescopes please sketch and show depths.

GROUND LEVEL

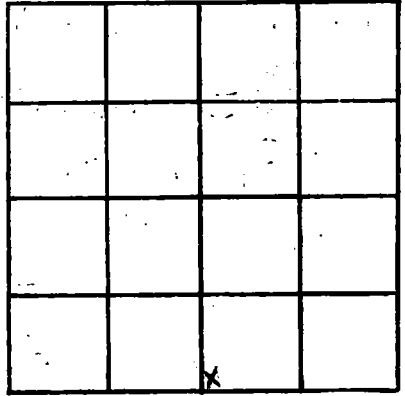

SECTION _____

Please indicate well location X.

ADDITIONAL INFORMATION

If more than one screen, show locations of each on sketch.