


If well telescopes please sketch and show depths.

GROUND LEVEL

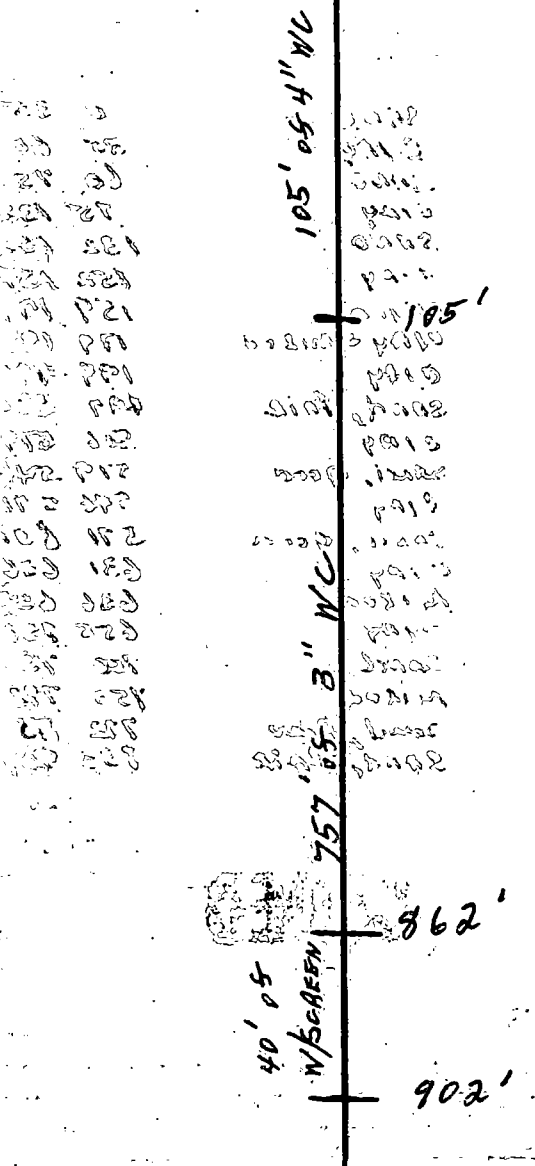

*			
	2212		

SECTION 6

Please indicate well location X.

ADDITIONAL INFORMATION

Blank lines for additional information.

If more than one screen, show locations of each on sketch.