

HARRISON
M414
12-15-70

MISSISSIPPI
 BOARD OF WATER COMMISSIONERS
 416 North State Street
 Jackson, Mississippi 39201
WATER WELL DRILLERS LOG

CODED

12-15 1970 Switzer Well Co. HARRISON
 date well completed firm name county well located

LANDOWNER: E. J. Ellzey
 DRAWER E
VENICE, LA. 70091
 (mailing address)

WELL LOCATION:
 sec. 24 T. 7 S. R. 10 W.
1 miles N of Biloxi
 (distance) (direction) (nearest town)

WELL PURPOSE: Home
 (home, irrigation, municipal, industrial)

WELL COMPLETION DATA:
 (1) diameter (inches) 2"
 (2) total depth (feet) 421'
 (3) static water level (feet) 18' (below ^{above} top of ground.)
 (4) casing galv. (material) 421' (depth)
4x2 if telescope see back.
 (size)
 (5) screen 20' (length) 401' (depth to top)
008, stainless steel
 (size) (material)
 (6) pump 1 (HP) 13 (yield gpm)
ELECT
 (type power)
 (7) electric log No (yes or no)

 (organization running log)

description of formations encountered	from	to
CLAY	0	16
SAND	16	21
CLAY	21	60
SAND	60	95
CLAY	95	137
SAND	137	172
CLAY	172	219
SAND	219	234
CLAY	234	278
SAND	278	293
CLAY	293	304
SAND	304	330
CLAY	330	348
SAND	348	421

CODED


JAN 27 1971

MISS. DD. OF WATER COMM.

(8) how well bottom plugged back
pressure valve
 DRILLERS REMARKS: _____

If well telescopes please sketch and show depths.

GROUND LEVEL

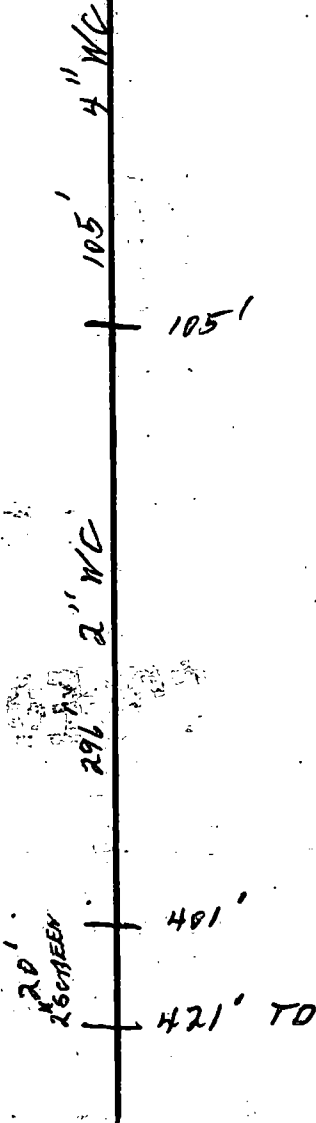

		X	

SECTION 24

Please indicate well location X.

ADDITIONAL INFORMATION

Handwritten notes and sketches in the 'ADDITIONAL INFORMATION' section include:

- Sketches of well components or screens.
- Vertical dimension lines with labels such as '20' SCREEN', '296', '401'', and '421' TO'.
- Other faint handwritten annotations.

If more than one screen, show locations of each on sketch.