

Harrison
M417
4-9-69

MISSISSIPPI
 BOARD OF WATER COMMISSIONERS
 416 North State Street
 Jackson, Mississippi 39201

CODED

WATER WELL DRILLERS LOG

APRIL 9, 1969 McGILL HARRISON
 date well completed firm name county well located

LANDOWNER: DELLA
ALSTON
GUILFORD
 (mailing address)

description of formations encountered	from to	
	feet	feet
<u>TOP SOIL</u>	<u>0</u>	<u>6</u>
<u>SAND</u>	<u>6</u>	<u>28</u>

WELL LOCATION:
 sec. 29 4 N R10 E
2 miles E of GUILFORD
 (distance) (direction) (nearest town)

WELL PURPOSE:
 (home, irrigation, municipal, industrial)

WELL COMPLETION DATA:
 (1) diameter (inches) 1 1/4
 (2) total depth (feet) 28
 (3) static water level (feet) 2 below top of ground.
 (4) casing galv (material) (depth)

(size) if telescope see back.
 (5) screen 5" 24
 (length) (depth to top)
2' SS
 (size) (material)

(6) pump 1 16
2 (HP) (yield gpm)
Free
 (type power)

(7) electric log no
 (yes or no)

(organization running log)

(8) how well bottom plugged BW

DRILLERS REMARKS:


CODED

JUN 30 1969

MISS. BD. OF
 WATER COMM.

If well telescopes please sketch and show depths.

GROUND LEVEL

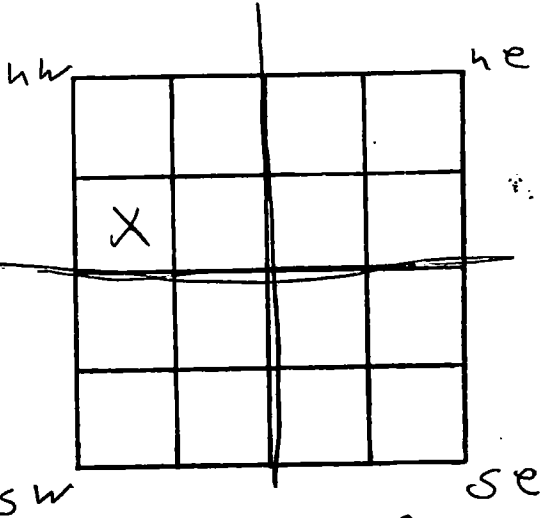

SECTION 29

Please indicate well location X.

ADDITIONAL INFORMATION

If more than one screen, show locations of each on sketch.