

HARRISON
M420
9-23-70

MISSISSIPPI
 BOARD OF WATER COMMISSIONERS
 416 North State Street
 Jackson, Mississippi 39201

CODED

WATER WELL DRILLERS LOG

9-23 1970 M. Hill Well Works Harrison
 date well completed firm name county well located

LANDOWNER: L. Hammond
2307 20th Ave.
Gulfport Miss.
 (mailing address)

description of formations encountered	depth	
	from	to
<u>top soil</u>	<u>0</u>	<u>3</u>
<u>sand</u>	<u>3</u>	<u>30</u>

WELL LOCATION:
 sec. 25 T. 07 N. R. 10 E
2 miles East of Gulfport
 (distance) (direction) (nearest town)

WELL PURPOSE:
 (home, irrigation, municipal, industrial)

WELL COMPLETION DATA:

(1) diameter (inches) 1 1/4"

(2) total depth (feet) 30'

(3) static water level (feet) 3' below top of ground.

(4) casing gal. pipe
 (material) (depth)
used if telescope see back.
 (size)

(5) screen 10' 20'
 (length) (depth to top)
1 1/4" S.S.
 (size) (material)

(6) pump 1/2 12
 (HP) (yield gpm)
Electric
 (type power)

(7) electric log No
 (yes or no)

(organization running log)

(8) how well bottom plugged point

CODED

JAN 21 1971


MISS. BD. OF
 WATER COMMISSIONERS

DRILLERS REMARKS:

If well telescopes please sketch and show depths.

1100

GROUND LEVEL

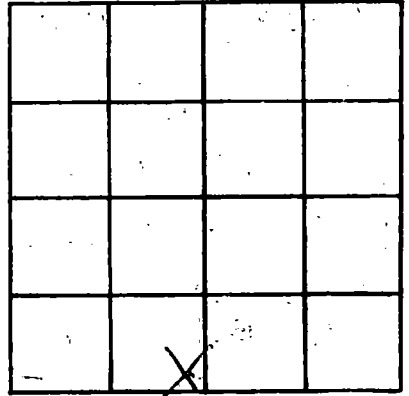

SECTION 25

Please indicate well location X.

ADDITIONAL INFORMATION

If more than one screen, show locations of each on sketch.