

VAR.

BM422 A130810

1-11-64

WATER WELL DRILLERS LOG

CODED

Date: 1-11, 1964, Driller: C. T. SWITZER WELL CO

(Name)

(1) Owner of Land: Pat Wilson
(Name)

Wadmarket Community
(Address)

(2) Location: 1/4, 1/4, Sec. 9 T. 2R9,
_____ miles _____ of _____
(distance) (direction) (Nearest Town)

(3) Topography: (Hilly) (Flat) (Level)

(4) Purpose of Well: Domestic
(Domestic Irrigation
Municipal, Industrial, Other)

Description & Color of Materials Sand, Clay, Red Clay, Shell, etc.	Thick- ness Feet	Depth Feet
Clay	10	13
Sand	13	34
Clay	34	134
Sand, fine	134	144
Clay	144	146
Sand, fine	146	166
Clay	166	269
Shell	269	423
Sand, fine	423	431
Sand	431	513

Information upon completion of well:

(1) Diameter 3 x 2 inches.


(2) Total Depth 513' feet.

(3) Water Level 44' feet below top of ground.

(4) Cased to 513', Size 3 x 2"

(5) Screen: Size 2", Length 10'

(6) Were any formations sealed against pollution?
✓ yes, _____ no.

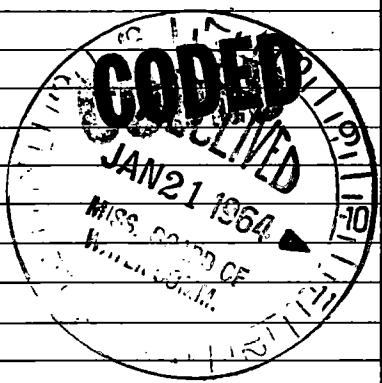

If YES depth of formation _____

Why Health Dept. requirement

Drillers Remarks: _____

Well No.

(Use Back Side)

1930

1930