

HAR.

MISSISSIPPI BOARD OF WATER COMMISSIONERS

M 924 W 110207

WATER WELL DRILLERS LOG

CODED

10-2-63

Date: Oct 2, 1963, Driller: Hattiesburg Butlers County, Harrison

(Name)

- (1) Owner of Land: Shirley C Graham
(Name)
#1 Biloxi, Miss.
(Address)
- (2) Location: 1/4, 1/4, Sec 9, T 7R10,
Woolmarket
miles, of
(distance) (direction) (Nearest Town)
- (3) Topography: hilly
(Hilly) (Flat) (Level)
- (4) Purpose of Well: domestic
(Domestic Irrigation
Municipal, Industrial, Other)

Description & Color of Materials
Sand, Clay, Red Clay, Shell, etc.

Thick-
ness
Feet

Depth
Feet


Red sand	0-8
yellow sand	8-15
white sand	15-25
Blue clay	25-38
Rock	38-40
white sand	40-47
gravel	47-53
Blue clay	53-120
Blue sand	120-128
Blue clay	128-185
Blue sand	185-210

Information upon completion of well:

- (1) Diameter 2 inches.
- (2) Total Depth 210 feet.
- (3) Water Level 44 feet below top of ground.
- (4) Cased to, Size
- (5) Screen: Size 2", Length 10'
- (6) Were any formations sealed against pollution?
yes, no.

If YES depth of formation
Why

Drillers Remarks:

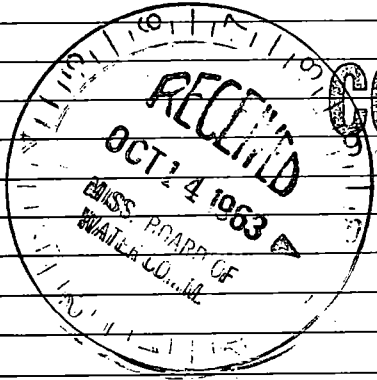

CODED

(Use Back Side)

Well No.

000000