

BM 425 W 110111

9-11-64


WATER WELL DRILLERS LOG

CODED

Date: 9-11, 1964, Driller: Hatterburg Butare County Stevenson
(Name)

(1) Owner of Land: A. R. Moore
(Name)
Rt 1, Belzoni, Miss
(Address)
Woolmarket
 (2) Location: 1/4, 1/4, Sec. 9 T 2 R 10,
_____ miles _____ of _____
(distance) (direction) (Nearest Town)
 (3) Topography: X
(Hilly) (Flat) (Level)
 (4) Purpose of Well: Domestic
(Domestic Irrigation Municipal, Industrial, Other)

Description & Color of Materials Sand, Clay, Red Clay, Shell, etc.	Thick- ness Feet	Depth Feet
<u>yellow clay</u>	<u>0-</u>	<u>8</u>
<u>white sand</u>	<u>8-</u>	<u>18</u>
<u>Blue clay</u>	<u>18-</u>	<u>98</u>
<u>Blue sand</u>	<u>98-</u>	<u>120</u>

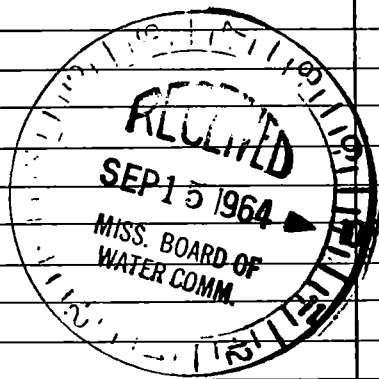

CODED

Information upon completion of well:

(1) Diameter 2 inches.

(2) Total Depth 120 feet.

(3) Water Level 20 feet below top of ground.

(4) Cased to _____, Size _____.

(5) Screen: Size 2", Length 10'.

(6) Were any formations sealed against pollution?
 _____ yes, X no.

If YES depth of formation _____

Why _____

Drillers Remarks: _____

Well No.

(Use Back Side)

