

HAR.

BM 426 W 109802

WATER WELL DRILLERS LOG

C. T. SWITZER WELL

CODED

Date: 11-5, 1963, Driller: County: Warren

11-5-63

(Name)

(1) Owner of Land: Curtis Hudson

(Name)

Calvary 15 - Woodmarket

(Address)

(2) Location: 1/4, 1/4, Sec. 7 T7 RD

miles of (distance) (direction) (Nearest Town)

(3) Topography: (Hilly) (Flat) (Level)

(4) Purpose of Well: Domestic (Domestic Irrigation, Municipal, Industrial, Other)

Description & Color of Materials Sand, Clay, Red Clay, Shell, etc.

Thickness Feet

00-15	clay	
15-20	sand	
20-100	red sand	
100-150	clay	
150-200	sand	
200-205	clay	
205-225	fine sand	
225-222	clay	
222-300	sand	
300-326	clay	
326-340	sand	
340-344	sp. sand	
344-394	clay	
394-400	sand	
400-460	sp. sand	

Information upon completion of well:

(1) Diameter: 243 inches.

(2) Total Depth: 460 feet.

(3) Water Level: 96' - feet below top of ground.

(4) Cased to 460', Size 243"

(5) Screen: Size 2", Length 10'


(6) Were any formations sealed against pollution? yes, no.

If YES depth of formation

Why: Health Dept require

Drillers Remarks:

CODED

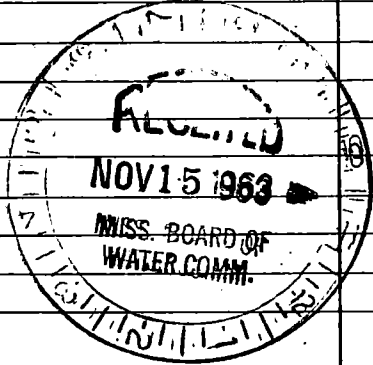

(Use Back Side)

Well No.

1300