

HARRISON
M 429
3-1-71

MISSISSIPPI
BOARD OF WATER COMMISSIONERS
416 North State Street
Jackson, Mississippi 39201
WATER WELL DRILLERS LOG

CODED

march 1 19 71 L. L. Garland Harrison
date well completed firm name county well located

LANDOWNER: James W. Clinton
Rt. 3 Box 89
Big Ridge Rd.
Biloxi, Miss.
(mailing address)

description of formations encountered from to

WELL LOCATION:
sec. 9 T. 7 N. R. 9 E.
S W
_____ miles of N. Biloxi
(distance) (direction) (nearest town)

WELL PURPOSE: home
(home, irrigation, municipal, industrial)

WELL COMPLETION DATA:
(1) diameter (inches) 2
(2) total depth (feet) 832
(3) static water level (feet) 18 below above top of ground.
(4) casing steel, 822,
(material) (depth)
2"
(size) if telescope see back.
(5) screen 10ft, 822
(length) (depth to top)
2", S. steel
(size) (material)
(6) pump _____ (HP) _____ (yield gpm)
Customer has
(type power) own pump
(7) electric log _____ (yes or no)

(organization running log)

CODED

(8) how well bottom plugged Back w. valve


MAR 8 - 1971

DRILLERS REMARKS:
23 ft. water bearing
sand

MISS. BD. OF
WATER COMM.

If well telescopes please sketch and show depths.

GROUND LEVEL

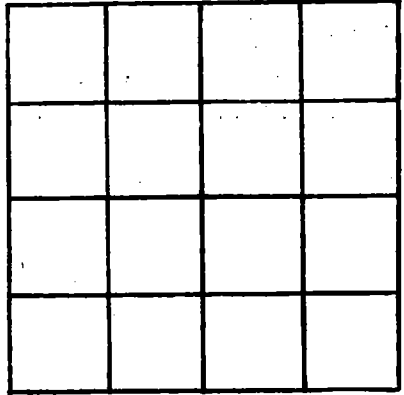

SECTION _____

Please indicate well location X.

ADDITIONAL INFORMATION

Lined area for providing additional information.

If more than one screen, show locations of each on sketch.