

HAR.  
M431

D 92540  
WATER WELL DRILLERS LOG

M-319

7-5-60

**CODED**

Date: July 5, 1960, Driller: C. J. Switzer (Name)

(1) Owner of Land: Mrs Lucy Ewin  
(Name)  
Box 75 West Black  
Biloxi, Miss.  
(Address)  
35 710

(2) Location: 1/4, 1/4, Sec. T R  
3 1/2 miles W of Biloxi  
(distance) (direction) (Nearest Town)

(3) Topography:  (Hilly)  (Flat)  (Level)

(4) Purpose of Well: Domestic  
(Domestic Irrigation Municipal, Industrial, Other)

Description & Color of Materials Sand, Clay, Red Clay, Shell, etc.	Thick- ness Feet	Depth Feet
<u>White sand</u>	<u>30</u>	<u>30</u>
<u>Blue clay</u>	<u>186</u>	<u>216</u>
<u>fine sand</u>	<u>55</u>	<u>271</u>
<u>Blue clay</u>	<u>169</u>	<u>440</u>
<u>Coarse sand</u>	<u>38</u>	<u>478</u>

Information upon completion of well:

(1) Diameter: 2" x 3" inches.

(2) Total Depth: 478 feet.

(3) Water Level: 1' feet below top of ground. 63' or 3"

(4) Cased to 41.5', Size 2"

(5) Screen: Size 1/8" x 1/8", Length 20'


(6) Were any formations sealed against pollution?  
 yes,  no.

If YES depth of formation: 10 feet

Why: Health dept. requirements

Drillers Remarks:

**CODED**

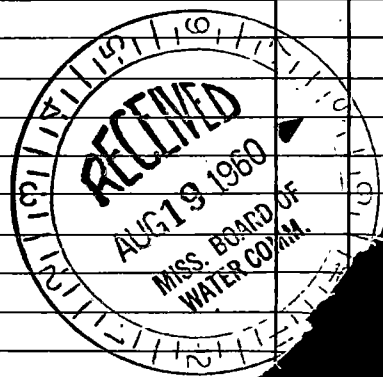

(Use Back)

### PATIENT REPORT

Name of Patient	
Address	
City	
State	
Date of Admission	Date of Discharge
Room No.	
Nurse's Name	
Physician's Name	
Diagnosis	
Treatment	
Progress	
Remarks	

--	--	--	--	--	--	--	--	--	--	--	--	--	--	--	--	--	--	--	--