

M437

3-16-61

WATER WELL DRILLERS LOG

CODED

333

Date: 3/16, 19 61, Driller: Hattiesburg Bore, County Harrison

(Name)

(1) Owner of Land: Grace Jackson (Name)

Mississippi City Miss 983-5th St (Address)

(2) Location: 1/4, 1/4, Sec. 32, R. 7, S. 10, 1 mile N of Mississippi City (distance) (direction) (Nearest Town)

(3) Topography: Level (Hilly) (Flat) (Level)

(4) Purpose of Well: Domestic (Domestic Irrigation Municipal, Industrial, Other)

Description & Color of Materials Sand, Clay, Red Clay, Shell, etc.

Thick-ness Feet

Depth Feet

White sand 0-10 Brown sand 10-40 Shell 40-56 Blue clay 56-160 Gray sand 160-180

CODED

Information upon completion of well:

(1) Diameter 2 inches.

(2) Total Depth 180 feet.

(3) Water Level 20 feet below top of ground.

(4) Cased to, Size

(5) Screen: Size 2", Length 10'


(6) Were any formations sealed against pollution?

yes, A no.

If YES depth of formation


Why

Drillers Remarks:

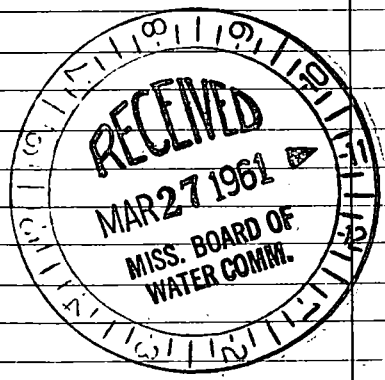

(Use Back Side)

Well No.

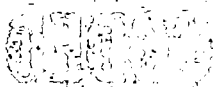

Handwritten text or scribbles at the top of the page.

A horizontal line of text or a separator line.

Handwritten text or scribbles in the middle of the page.

Handwritten text or scribbles at the bottom of the page.