

HAR.

MISSISSIPPI BOARD OF WATER COMMISSIONERS

M 438

M D 90438

?

4-17-61

WATER WELL DRILLERS LOG

CODED

Date: April 17, 1961, Driller: C.T. Switzer Well Co. County: Harrison
(Name)

(1) Owner of Land: Jacob Fallo
(Name)

Jem money Rd
(Address)

(2) Location: 23 710
1/4, 1/4, Sec. T R

_____ miles _____ of _____
(distance) (direction) (Nearest Town)

(3) Topography: X
(Hilly) (Flat) (Level)

(4) Purpose of Well: Domestic
(Domestic Irrigation
Municipal, Industrial, Other)

Description & Color of Materials Sand, Clay, Red Clay, Shell, etc.	Thick- ness Feet	Depth Feet
Surface sand	0	58
Clay	58	110
Clay & Sand streaks	110	131
Clay	131	136
Clay & Sand streaks	136	145
Sand	145	165
Clay	165	195
Clay & Sand streaks	195	201
clay	201	261
Sand fine	261	269
Clay	269	369
Clay & Sand streaks	369	402
Sand	402	448

Information upon completion of well:


- (1) Diameter 2" inches.
- (2) Total Depth 448 feet.
- (3) Water Level 8 1/2 - feet below top of ground.
- (4) Cased to 448, Size 2"
- (5) Screen: Size to 2', Length 10'
- (6) Were any formations sealed against pollution?
X yes, _____ no.

If YES depth of formation _____

Why Health Dept Requirement

Drillers Remarks: _____

CODED

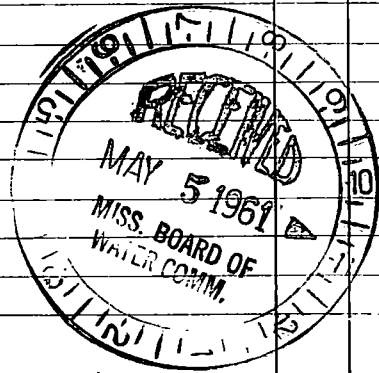

(Use Back Side)

Well No.

1915

1915

1915

[The remainder of the page contains extremely faint and illegible text, likely bleed-through from the reverse side of the document.]